USE TYPEWRITER OR BALL POINT PEN-PRESS FIRMLY, PRINT CLEARLY.

WATER WELL RECORD
KSA 82a-1201-1215

ACD

Kansas Department of Health and Environment-Division of Environment
(Water well Contractors)
Topeka, Kansas 66620

1. Location of well:	County	Fraction	Section number	Township number	Range number
	Wallace	Middle of South side of SW 1/4 NE 1/4	22	T 14 S	R 40 E/W

2. Distance and direction from nearest town or city: five miles South of Sharon Springs, Kans
Street address of well location if in city:

3. Owner of well: R. D. Walker
R.R. or street: RR #1
City, state, zip code: Sharon Springs, Kansas 67758

4. Locate with "X" in section below:

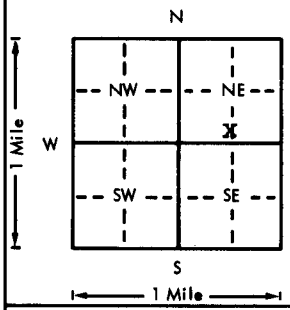

Sketch map: Middle of South side of NE¼, Sect 22 ~~XXXXX~~ twp 14 Rge 40

5. Type and color of material	From	To
clay and sand	0	137
medium to coarse	137	191
clay sticky	191	198
medium to good	198	207
soapstone	207	213
blue	213	222
BROCK 207'		

(Use a second sheet if needed)

6. Bore hole dia. 30 in. Completion date 1-29-77
Well depth 222 ft.

7. __ Cable tool __ Rotary __ Driven __ Dug
__ Hollow rod __ Jetted __ Bored X Reverse rotary

8. Use: __ Domestic __ Public supply __ Industry
X Irrigation __ Air conditioning __ Stock
__ Lawn __ Oil field water __ Other

9. Casing: Material steel Height: Above or below
Threaded ___ Welded X Surface 12 in.
RMP ___ PVC ___ Weight 36 lbs./ft.
Dia. 16 in. to 222 ft. depth Wall Thickness: inches or
Dia. ___ in. to ___ ft. depth gage No. .219

10. Screen: Manufacturer's name Lakewood Pipe
Type steel Dia. 16"
Slot/gauge 2" Length 90'
Set between 117 ft. and 207 ft.
___ ft. and ___ ft.
Gravel pack? yes Size range of material 3/8

11. Static water level: mo./day/yr.
146 ft. below land surface Date 3-19-77

12. Pumping level below land surfaces:
210 ft. after 6 hrs. pumping 750 g.p.m.
___ ft. after ___ hrs. pumping ___ g.p.m.
Estimated maximum yield 750 g.p.m.

13. Water sample submitted: no mo./day/yr.
___ Yes ___ No Date

14. Well head completion:
___ Pitless adapter 12 Inches above grade

15. Well grouted?
With: X Neat cement ___ Bentonite ___ Concrete
Depth: From 0 ft. to 10 ft.

16. Nearest source of possible contamination: none
ft. ___ Direction ___ Type ___
Well disinfected upon completion? ___ Yes ___ No

17. Pump: ___ Not installed
Manufacturer's name Peerless
Model number ___ HP 100 Volts ___
Length of drop pipe 210 ft. capacity 750 g.p.m.
Type:
___ Submersible X Turbine
___ Jet ___ Reciprocating
___ Centrifugal ___ Other

T 14 R 40 E/W Sec 22 1/4 CNE 1/4 1/4

18. Elevation:
Topography:
___ Hill
X Slope
___ Upland
___ Valley

19. Remarks:

20. Water well contractor's certification:
This well was drilled under my jurisdiction and this report is true to the best of my knowledge and belief.
Northwest Drilling Co., Inc 248
Business name License No.
Address Goodland, Kansas
Signed Ben Harz Date 5-24-77
Authorized representative

Forward the white, blue and pink copies to the Department of Health and Environment

Form WWC-5