

USE TYPEWRITER OR BALL POINT PEN - PRESS FIRMLY, PRINT CLEARLY.

# SOUTH FLATS

T R EW sec 1/4 1/4 1/4 No.


WATER WELL RECORD  
KSA 82a-1201-1215

Kansas State Dept. Of Health  
(Water Well Contractors)  
Forbes-Bldg. 740  
Topeka, Kansas 66620

DOB

1 Location of well:	County: <u>Wallace</u>	Township name: <u>14 N 5 W</u>	Fraction: <u>SE 4</u>	Section number: <u>25</u>	Town number: <u>145</u>	Range number: <u>40</u>
---------------------	------------------------	--------------------------------	-----------------------	---------------------------	-------------------------	-------------------------

Distance and direction from nearest town or city:	3 Owner of well: <u>Ron Bricker</u>
Street address of well location if in city:	Address: <u>Wallace Ks.</u>

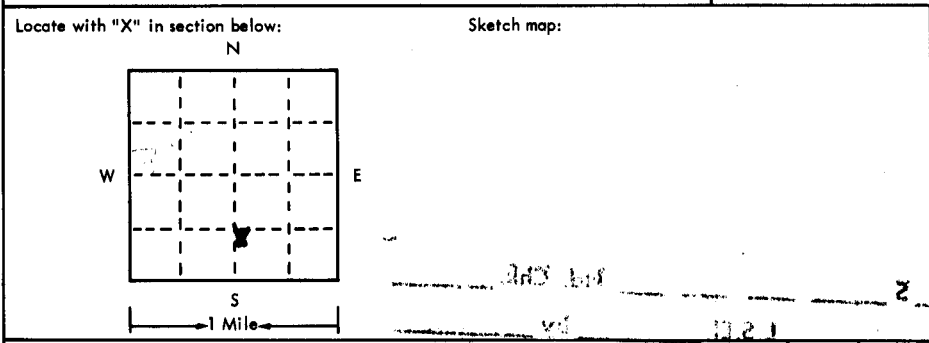

4 Well depth: 125 ft. Date of completion 1-22-75  
Well diameter 28 in.

5  Cable tool  Rotary  Driven  Dug  
 Hollow rod  Jetted  Bored  Reverse rotary

6 Use:  Domestic  Public supply  Industry  
 Irrigation  Air conditioning  Commercial  
 Test well

7 Casing: Material Steel Height: above/below  
Threaded  Welded  Surface \_\_\_\_\_ in.  
Diam. 12 3/4 in. to 102 ft. depth Weight \_\_\_\_\_ lbs./ft.  
Drive shoe?  Yes  No

2 Type and color of material	From	To
<u>Gravel traces Sandstone &amp; Sandy clay</u>	<u>104</u>	<u>108</u>
<u>Gravel trace Sandstone</u>	<u>108</u>	<u>116</u>
<u>Sandy clay &amp; Gravel (Brown)</u>	<u>116</u>	<u>118</u>
<u>Sandstone Medium Gravel (Brown)</u>	<u>118</u>	<u>119</u>
<u>Sandy clay &amp; Medium Gravel (Brown)</u>	<u>119</u>	<u>125</u>
<u>Med Gravel &amp; Fine Sand (Brown)</u>	<u>125</u>	<u>126</u>
<u>Med Gravel, Fine Sand &amp; Sandstone</u>	<u>126</u>	<u>135</u>
<u>Gravel (Brown)</u>	<u>135</u>	<u>138</u>
<u>Med Gravel &amp; Sand stone</u>	<u>138</u>	<u>140</u>
<u>Sandy clay Sandstone &amp; Fine sand</u>	<u>140</u>	<u>141</u>
<u>Sandy clay (Brown)</u>	<u>141</u>	<u>149</u>
<u>Sandy clay traces Sandstone &amp; Fine Sand</u>	<u>149</u>	<u>152</u>
<u>Sandy clay &amp; Fine Sand (Brown)</u>	<u>152</u>	<u>160</u>
<u>Sandy clay &amp; Medium Gravel</u>	<u>160</u>	<u>163</u>
<u>Gravel (Brown)</u>	<u>163</u>	<u>164</u>
<u>Sandy clay &amp; Med Gravel (Brown)</u> <small>(Use a second sheet if needed)</small>	<u>164</u>	<u>169</u>

8 Screens: \_\_\_\_\_  
Manufacturer \_\_\_\_\_  
Type Slot Dia. 12 3/4  
Slot/gauge \_\_\_\_\_ Length \_\_\_\_\_  
Set between 105 and 125 ft.  
Fittings: \_\_\_\_\_  
 Gravel pack  No Size range of material \_\_\_\_\_

9 Static water level: 102 ft. below land surface Date 1-19-75

10 Pumping level below land surfaces:  
168 ft. after 6 hrs. pumping 970 g.p.m.  
\_\_\_\_\_ ft. after \_\_\_\_\_ hrs. pumping \_\_\_\_\_ g.p.m.  
Estimated maximum yield 970 g.p.m.

11 Water sample submitted:  
 Yes  No Date \_\_\_\_\_

12 Well head completion:  
 Pitless adapter  \_\_\_\_\_ inches above grade

13 Well grouted?  Yes  No  
 Neat cement  Bentonite  \_\_\_\_\_  
Depth: From \_\_\_\_\_ ft. to \_\_\_\_\_ ft.

14 Nearest source of possible contamination:  
ft. \_\_\_\_\_ Direction \_\_\_\_\_ Type \_\_\_\_\_  
Well disinfected upon completion?  Yes  No

15 Pump:  Not installed  
Manufacturer's name \_\_\_\_\_  
Model number \_\_\_\_\_ HP \_\_\_\_\_ Volts \_\_\_\_\_  
Length of drop pipe \_\_\_\_\_ ft. capacity \_\_\_\_\_ g.m.p.  
Type:  
 Submersible  Turbine  
 Jet  Reciprocating  
 Centrifugal  Other

16 Remarks: elevation 3572 (TOPO) BROCK 173'

Topography:  
 Hill  
 Slope  
 Upland  
 Valley

17 Water well contractor's certification:  
This well was drilled under my jurisdiction and this report is true to the best of my knowledge and belief.  
Red Tiger Tool 125  
Business name License No.  
Address Colby Ks Box 524  
Signed Don Stamer Date 5-8-75  
Authorized representative

