

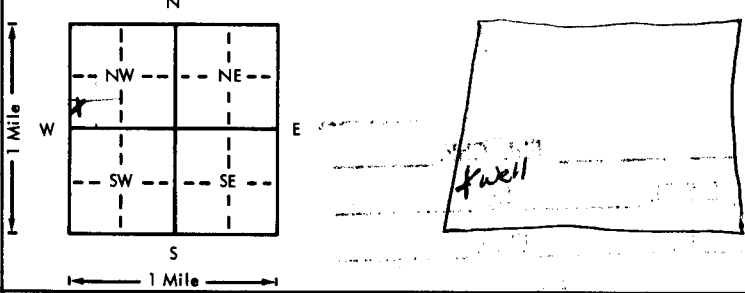
SOUTH FLATS

USE TYPEWRITER OR BALL POINT PEN—PRESS FIRMLY, PRINT CLEARLY.

WATER WELL RECORD
KSA 82a-1201-1215

Kansas Department of Health and Environment—Division of Environment
(Water well Contractors)
Topeka, Kansas 66620

BCC

1. Location of well: County WALLACE Fraction SW 1/4 SW 1/4 NW 1/4 Section number 25 Township number T 14 Range number S R 40 E W	
2. Distance and direction from nearest town or city: 6.5 E 1/4 N Street address of well location if in city: SHARON SPRINGS 3. Owner of well: RUSSELL UNRUH R.R. or street: City, state, zip code: SHARON SPRINGS KANS.	
4. Locate with "X" in section below: Sketch map: 	
5. Type and color of material	
	From To
Clay Gravel & Sandstone	0 131
Gravel	131 138
Clay	138 147
Gravel	147 154
Clay & Sandstone	154 169
Sand	169 172
Clay & Sandstone	172 188
Gravel	188 201
Clay	201 206
Gravel	206 225
Soapstone	225 229
Shale	229 235
(Use a second sheet if needed)	
18. Elevation:	19. Remarks: 3628 (TOPO) 24 Concrete Rise Foust Supply Co Inc.
20. Water well contractor's certification: This well was drilled under my jurisdiction and this report is true to the best of my knowledge and belief. Foust Supply Co Inc License No. 144 Business name Box 338 Address Signed Ralph Elmer Date 2-25-77 Authorized representative	

6. Bore hole dia. 2 1/2 in. Completion date 5-1-76 Well depth 235 ft.
7. Cable tool <input type="checkbox"/> Rotary <input type="checkbox"/> Driven <input type="checkbox"/> Dug <input type="checkbox"/> Hollow rod <input type="checkbox"/> Jetted <input type="checkbox"/> Bored <input checked="" type="checkbox"/> Reverse rotary
8. Use: Domestic <input type="checkbox"/> Public supply <input type="checkbox"/> Industry <input type="checkbox"/> <input checked="" type="checkbox"/> Irrigation <input type="checkbox"/> Air conditioning <input type="checkbox"/> Stock <input type="checkbox"/> Lawn <input type="checkbox"/> Oil field water <input type="checkbox"/> Other
9. Casing: Material Steel Height: Above or below Threaded <input type="checkbox"/> Welded <input checked="" type="checkbox"/> Surface 8 in. RMP <input type="checkbox"/> PVC <input type="checkbox"/> Weight 33 lbs./ft. Dia. 8 in. to 13 1/2 ft. depth Wall thickness inches or Dia. <input type="checkbox"/> in. to <input type="checkbox"/> ft. depth gage No. 189
10. Screens: Manufacturer's name W.A. Brown Type M.I.S.O.I.T Dia. 1 1/2 Slot/gauze 1/16 Length 100 Set between 136 ft. and 236 ft. ft. and <input type="checkbox"/> ft. Gravel pack? <input checked="" type="checkbox"/> Size range of material 3/8
11. Static water level: mo./day/yr. 129 ft. below land surface Date 2-11-76
12. Pumping level below land surfaces: 240 ft. after 8 hrs. pumping 800 g.p.m. 220 ft. after 16 hrs. pumping 1280 g.p.m. Estimated maximum yield 1280 g.p.m.
13. Water sample submitted: mo./day/yr. Yes <input checked="" type="checkbox"/> No <input type="checkbox"/> Date
14. Well head completion: <input type="checkbox"/> Pitless adapter <input type="checkbox"/> inches above grade
15. Well grouted? <input checked="" type="checkbox"/> With: <input checked="" type="checkbox"/> Neat cement <input type="checkbox"/> Bentonite <input type="checkbox"/> Concrete Depth: From 8 1/2 ft. to 10 ft.
16. Nearest source of possible contamination: Field ft. <input type="checkbox"/> Direction <input type="checkbox"/> Type <input type="checkbox"/> Well disinfected upon completion? Yes <input type="checkbox"/> No <input checked="" type="checkbox"/>
17. Pump: Not installed Manufacturer's name AFC Model number GT244 HP <input type="checkbox"/> Volts <input type="checkbox"/> Length of drop pipe 220 ft. capacity 1280 g.p.m. Type: <input type="checkbox"/> Submersible <input checked="" type="checkbox"/> Turbine <input type="checkbox"/> Jet <input type="checkbox"/> Reciprocating <input type="checkbox"/> Centrifugal <input type="checkbox"/> Other

T 14 R 40 E 25 SW 1/4 NW 1/4