

USE TYPEWRITER OR BALL POINT PEN-PRESS FIRMLY, PRINT CLEARLY.


WATER WELL RECORD
KSA 82a-1201-1215

Kansas Department of Health and Environment-Division of Environment (Water well Contractors) Topeka, Kansas 66620

DIA

1. Location of well: County WALLACE Action Action NE 1/4 SE 1/4 SE 1/4 Section number 25 Township number T 14 Range number S R 40 NW

2. Distance and direction from nearest town or city: 6.5 1/2 E 3. Owner of well: Russel Unruh
Street address of well location if in city: SHARON SHRINASS-KAY R.B. or street:
City, state, zip code: Sharon Springs, Kansas 67758

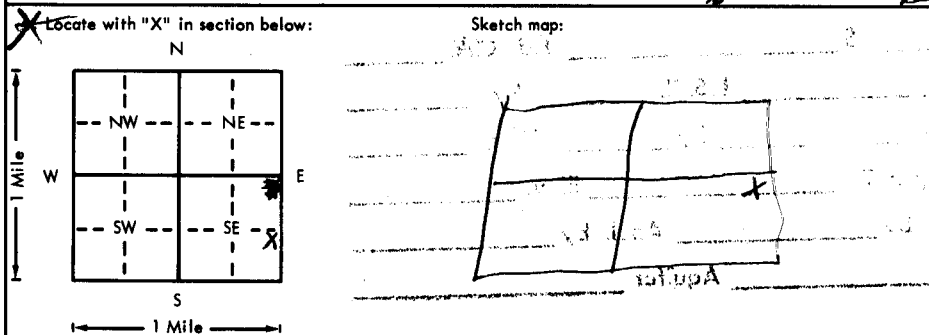

6. Bore hole dia. 2 1/2 in. Completion date 8-12-76
Well depth 182 ft.

7. Cable tool Rotary Driven Dug
 Hollow rod Jetted Bored Reverse rotary

8. Use: Domestic Public supply Industry
 Irrigation Air conditioning Stock
 Lawn Oil field water Other

9. Casing: Material Steel Height: Above or below
Threaded Welded Surface 8 in.
RMP PVC Weight 32 lbs./ft.
Dia. 2 in. to 182 ft. depth Wall Thickness: inches or
Dia. in. to ft. depth Gage No. 188

5. Type and color of material	From	To
Top Soil & clay	0	81
Gravel	81	88
Gravel	88	91
Sand & Clay	91	138
Gravel	138	145
Sandy clay	145	150
Gravel	150	155
Clay	155	158
Gravel	158	164
Soapstone	164	174
Shale	174	180
<u>BROCK 14'</u>		
(Use a second sheet if needed)		

10. Screen: Manufacturer's name U.A. Brown
Type Mill Silt Dia. 16
Slot/gauze 1/8 Length 300
Set between 100 ft. and 182 ft.
ft. and ft.
Gravel pack? Size range of material 1/2"

11. Static water level: 70 ft. below land surface Date mo./day/yr.

12. Pumping level below land surfaces:
120 ft. after 8 hrs. pumping 700 g.p.m.
160 ft. after 16 hrs. pumping 930 g.p.m.
Estimated maximum yield 930 g.p.m.

13. Water sample submitted: mo./day/yr.
 Yes No Date

14. Well head completion:
 Pitless adapter Inches above grade

15. Well grouted?
With: Neat cement Bentonite Concrete
Depth: From 16 ft. to 8" ft. Above

Nearest source of possible contamination:
ft. Direction Type
Well disinfected upon completion? Yes No

17. Pump: Not installed
Manufacturer's name TAIT H9C
Model number HA 820A HP Volts
Length of drop pipe 170 ft. capacity 930 g.p.m.
Type:
 Submersible Turbine
 Jet Reciprocating
 Centrifugal Other

18. Elevation:

Topography:
 Hill
 Slope
 Upland
 Valley

19. Remarks:
CONCRETE WAS RUN
By Foust Supply Co.

20. Water well contractor's certification:
This well was drilled under my jurisdiction and this report is true to the best of my knowledge and belief.
Foust Supply Co. Inc 144
Business name License No.
Address Box 338 Goodland, Kan
Signed Ralph E. ... Date 10-14-76
Authorized representative

174
40
25
NE SE SE
1/4 1/4 1/4
SEC
1/4 1/4 1/4