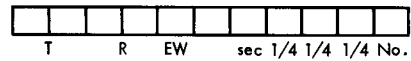


SOUTH FLATS

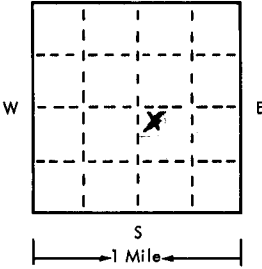
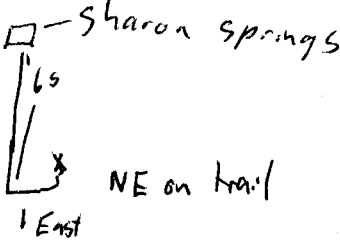
USE TYPEWRITER OR BALL POINT PEN—PRESS FIRMLY, PRINT CLEARLY.



WATER WELL RECORD
KSA 82a-1201-1215

Kansas State Dept. Of Health
(Water Well Contractors)
Forbes-Bldg. 740
Topeka, Kansas 66620

DBB

1 Location of well:	County Wallace	Township name Sharon Springs	Fraction NNWSE	Section number 25	Town number 14S	Range number 40W
Distance and direction from nearest town or city: 6 South 1/2 east of Sharon Springs Kans			3 Owner of well: Ronald Bricker Address: Sharon Springs Kansas			
Locate with "X" in section below: N  W E S 1 Mile		Sketch map: 		4 Well depth: 174 ft. Date of completion 9-8-75 Well diameter 4 1/2 in.		
2 Type and color of material		From To		5 <input type="checkbox"/> Cable tool <input checked="" type="checkbox"/> Rotary <input type="checkbox"/> Driven <input type="checkbox"/> Dug <input type="checkbox"/> Hollow rod <input type="checkbox"/> Jetted <input type="checkbox"/> Bored <input type="checkbox"/> Reverse rotary		
				6 Use: <input checked="" type="checkbox"/> Domestic <input type="checkbox"/> Public supply <input type="checkbox"/> Industry <input type="checkbox"/> Irrigation <input type="checkbox"/> Air conditioning <input type="checkbox"/> Commercial <input type="checkbox"/> Test well <input type="checkbox"/>		
clay		0 35		7 Casing: Material Plastic Height: above below Threading <input type="checkbox"/> Welded <input type="checkbox"/> Surface 2 1/4 in. Diam. 4 1/2 in. Weight 131 lbs./ft. 4 1/2 in. to 174 ft. depth Drive shoe? <input type="checkbox"/> Yes <input type="checkbox"/> No		
				8 Screen: Manufacturer Sec Mac Plastic Type 5/8 RMP Dia. 4.5" <input checked="" type="checkbox"/> Slot gauze 1/16 Length 20 ft Set between 154 ft. and 174 ft. Fittings: Gravel pack <input checked="" type="checkbox"/> Yes <input type="checkbox"/> No Size range of material 1/8		
sand		35 95		9 Static water level: 60 ft. below land surface Date 9-8-75		
clay		95 105		10 Pumping level below land surfaces: 60 ft. after 1 hrs. pumping 25 g.p.m. ____ ft. after ____ hrs. pumping ____ g.p.m. Estimated maximum yield ____ g.p.m.		
sand + gravel		105 170		11 Water sample submitted: <input type="checkbox"/> Yes <input checked="" type="checkbox"/> No Date ____		
oakra		170 174		12 Well head completion: <input type="checkbox"/> Pitless adapter 25 inches above grade		
BROOK 170'				13 Well grouted? <input checked="" type="checkbox"/> Yes <input type="checkbox"/> No <input checked="" type="checkbox"/> Neat cement <input type="checkbox"/> Bentonite <input type="checkbox"/> Depth: From 0 ft. to 25 ft.		
				14 Nearest source of possible contamination: ft. None Direction ____ Type ____ Well disinfected upon completion? <input checked="" type="checkbox"/> Yes <input type="checkbox"/> No		
3575 175 340				15 Pump: <input type="checkbox"/> Not installed Manufacturer's name Windmill Model number ____ HP ____ Volts ____ Length of drop pipe 96 ft. capacity 5 g.m.p. Type: <input type="checkbox"/> Submersible <input type="checkbox"/> Turbine <input type="checkbox"/> Jet <input checked="" type="checkbox"/> Reciprocating <input type="checkbox"/> Centrifugal <input type="checkbox"/> Other		
				16 Remarks: elevation 3575 (TOPO)		
16 Remarks: elevation Topography: <input type="checkbox"/> Hill <input type="checkbox"/> Slope <input type="checkbox"/> Upland <input checked="" type="checkbox"/> Valley				17 Water well contractor's certification: This well was drilled under my jurisdiction and this report is true to the best of my knowledge and belief. Kemp's Well Service 213 Business name License No. ____ Address Cheyenne Wells Colo Signed Ronald Kemp Date 9-8-75 Authorized representative		

14 40W 25 NNWSE