

USE TYPEWRITER OR BALL POINT PEN—PRESS FIRMLY, PRINT CLEARLY.


WATER WELL RECORD  
KSA 82a-1201-1215

Kansas Department of Health and Environment—Division of Environment  
(Water well Contractors)  
Topeka, Kansas 66620

ACA

1. Location of well: County Wallace Fraction center of NE 1/4 SW 1/4 NE 1/4 Section number 31 Township number T 14 S R 40 Range number E/W

2. Distance and direction from nearest town or city: 6 1/4 south, 3 west, of Sharon Springs, Kansas  
Street address of well location if in city:  
3. Owner of well: Wayne Woodmancy  
R.R. or street:  
City, state, zip code: Sharon Springs, Kansas 67758

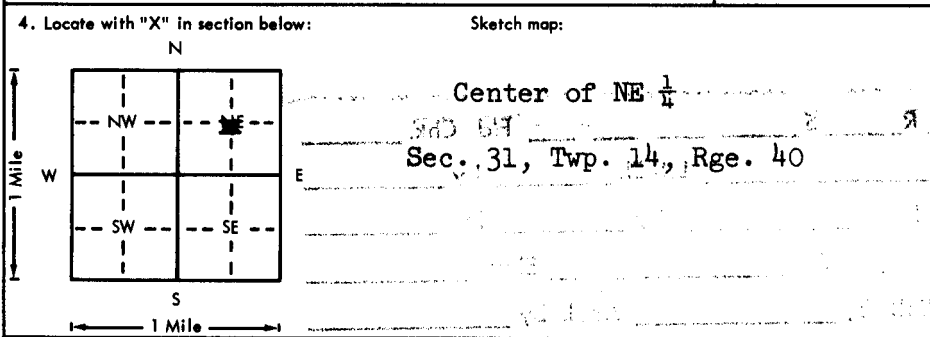

6. Bore hole dia. 30 in. Completion date \_\_\_\_\_  
Well depth 250 ft. 9-27-75

7. Cable tool  Rotary  Driven  Dug   
 Hollow rod  Jetted  Bored  Reverse rotary

8. Use:  Domestic  Public supply  Industry  Irrigation  Air conditioning  Stock  Lawn  Oil field water  Other

9. Casing: Material steel Height: Above or below  
Threaded  Welded  Surface 12 in.  
RMP \_\_\_\_\_ PVC \_\_\_\_\_ Weight 36 lbs./ft.  
Dia. 16 in. to 250 ft. depth; Wall Thickness: inches or  
Dia. 2 in. to 1 ft. depth; gauge No. .219

5. Type and color of material	From	To
sandy clay	0	40
sandy clay fine sand soft	40	60
sandy clay soft gravel	60	100
clay gray	100	120
sand fine	120	140
sandy clay most part sand	140	180
sand fine	180	220
sand coarse	220	246
clay	246	249
shale	249	250
<u>BROCK 249</u>		
(Use a second sheet if needed)		

10. Screen: Manufacturer's name W. A. Brown  
Type steel Dia. 16"  
Slot gauge 2" Length 100'  
Set between 150 ft. and 250 ft.  
Gravel pack?  Yes  No Size range of material 3/8

11. Static water level: \_\_\_\_\_ mo./day/yr.  
160 ft. below land surface Date 10-3-75

12. Pumping level below land surfaces:  
180 ft. after 5 hrs. pumping 800 g.p.m.  
\_\_\_\_\_ ft. after \_\_\_\_\_ hrs. pumping \_\_\_\_\_ g.p.m.  
Estimated maximum yield 800 g.p.m.

13. Water sample submitted: \_\_\_\_\_ mo./day/yr.  
Yes  No  Date \_\_\_\_\_

14. Well head completion:  
 Pitless adapter 12 inches above grade

15. Well grouted?  yes  
With:  Neat cement  Bentonite  Concrete  
Depth: From 0 ft. to 10 ft.

16. Nearest source of possible contamination: none  
ft. \_\_\_\_\_ Direction \_\_\_\_\_ Type \_\_\_\_\_  
Well disinfected upon completion? \_\_\_\_\_ Yes \_\_\_\_\_ No

17. Pump: \_\_\_\_\_ Not installed  
Manufacturer's name Peerless  
Model number Turbine HP 75 Volts \_\_\_\_\_  
Length of drop pipe 210 ft. capacity 800 g.p.m.  
Type:  
 Submersible  Turbine  
 Jet  Reciprocating  
 Centrifugal  Other

18. Elevation: \_\_\_\_\_  
Topography:  
 Hill  
 Slope  
 Upland  
 Valley

19. Remarks:

20. Water well contractor's certification:  
This well was drilled under my jurisdiction and this report is true to the best of my knowledge and belief.  
Northwest Drilling Co., Inc.  
Business name License No. \_\_\_\_\_  
Address Box 411, Goodland, Kansas  
Signed Ben Hays Date 8-3-76  
Authorized representative

T 14 S R 40 E  
Sec 31  
NE  
C/1735  
8-3-76