

USE TYPEWRITER OR BALL POINT PEN-PRESS FIRMLY, PRINT CLEARLY.


WATER WELL RECORD
KSA 82a-1201-1215

Kansas Department of Health and Environment-Division of Environment
(Water well Contractors)
Topeka, Kansas 66620

BAC

1. Location of well: County WALLACE Fraction SW 1/4 NE 1/4 NW 1/4 Section number 32 Township number T 14 S Range number R 40 W

2. Distance and direction from nearest town or city: SHARON SPRINGS
Street address of well location if in city: 75 2 3/4 W 45
3. Owner of well: D. A. HERMAN
R.R. or street:
City, state, zip code: SHARON SPRINGS KS. 67758

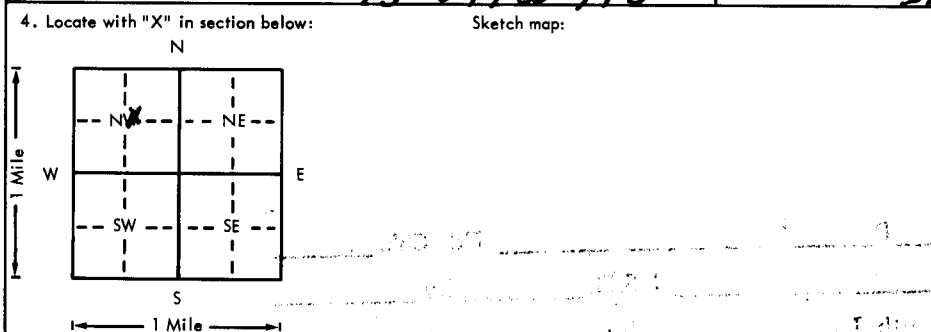

6. Bore hole dia. 2 1/2 in. Completion date _____
Well depth 211 ft. 5-22-77
7. Cable tool Rotary Driven Dug
 Hollow rod Jetted Bored Reverse rotary
8. Use: Domestic Public supply Industry
 Irrigation Air conditioning Stock
Lawn Oil field water Other
9. Casing: Material STEEL Height: Above below
Threaded Welded Surface 12 in.
RMP PVC Weight 36 lbs./ft.
Dia. 1 1/2 to 1 1/4 ft. depth Wall Thickness: inches or
Dia. 1 1/2 in. to _____ ft. depth gage No. 219

5. Type and color of material	From	To
M GRAVEL	85	91
FINE SAND, SANDY CLAY	91	115
FINE SAND, M GRAVEL	115	128
CLAY	128	136
FINE SAND	136	143
M GRAVEL	143	155
M GRAVEL, SANDY CLAY	155	175
M GRAVEL	175	191
M GRAVEL, TRACE CLAY	191	194
M GRAVEL	194	203
M GRAVEL, OCHRE	203	207
OCHRE	207	211
BROCK 207'		
(Use a second sheet if needed)		

10. Screen: Manufacturer's name W. B. BROWN
Type LOWER Dia. 16
Slot gage 1/8 x .188 Length 170
Set between 140 ft. and 211 ft.
2 x 15 m 28 ft. and _____ ft.
Gravel pack? YES Size range of material 1/4 x 2/8
11. Static water level: _____ mo./day/yr.
93 ft. below land surface Date 1-27-77
12. Pumping level below land surfaces:
202 ft. after 5 hrs. pumping 1510 g.p.m.
_____ ft. after _____ hrs. pumping _____ g.p.m.
Estimated maximum yield 1700 g.p.m.
13. Water sample submitted: _____ mo./day/yr.
Yes No Date _____
14. Well head completion:
 Pitless adapter _____ Inches above grade
15. Well grouted? YES
With: Neat cement Bentonite Concrete
Depth: From 0 ft. to 10 ft.
16. Nearest source of possible contamination:
ft. _____ Direction _____ Type NONE
Well disinfected upon completion? Yes No
17. Pump: _____ Not installed
Manufacturer's name WESTERN LEAD PULLER
Model number 8M HP 100 Volts _____
Length of drop pipe 190 ft. capacity 1200 g.p.m.
Type:
 Submersible Turbine
 Jet Reciprocating
 Centrifugal Other

18. Elevation:
Topography:
 Hill
 Slope
 Upland
 Valley
19. Remarks:

20. Water well contractor's certification:
This well was drilled under my jurisdiction and this report is true to the best of my knowledge and belief.
Business name St H Dullung Co Inc License No. 166
Address Shoeland Kansas
Signed Bill Clifford Date 5-24-77
Authorized representative

174 405 32 SW NE NW Sec 1/4 1/4 1/4