

USE TYPEWRITER OR BALL POINT PEN-PRESS FIRMLY, PRINT CLEARLY.


WATER WELL RECORD
KSA 82a-1201-1215

Kansas Department of Health and Environment-Division of Environment (Water well Contractors) Topeka, Kansas 66620

11315

Location of well: County Wallace Fraction SE 1/4 NW 1/4 SE 1/4 Section number 35 Township number T 14 S R 40 Range number E/W

Distance and direction from nearest town or city: five miles 1/2 mile south of Sharon Springs, Kans. 3. Owner of well: R. D. Walker
Street address of well location if in city: _____ R.R. or street: RR #1
City, state, zip code: Sharon Springs, Kansas 67758

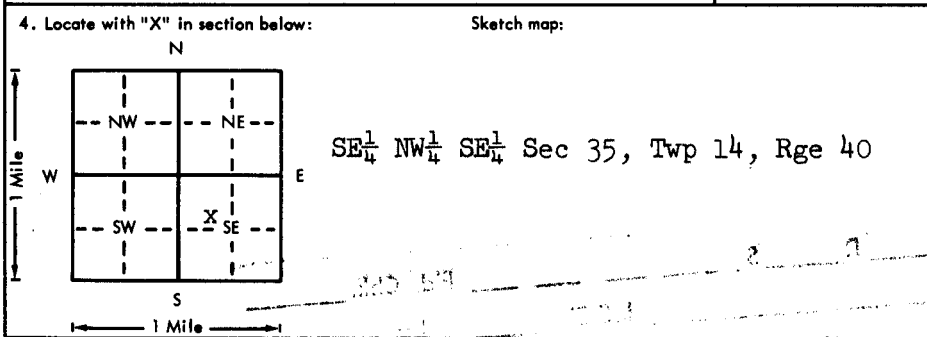

6. Bore hole dia. 30 in. Completion date 4-20-77
Well depth 250 ft.

7. Cable tool Rotary Driven Dug
 Hollow rod Jetted Bored Reverse rotary

8. Use: Domestic Public supply Industry
 Irrigation Air conditioning Stock
 Lawn Oil field water Other

9. Casing: Material steel Height: Above or below
Threaded: Welded Surface 12 in.
RMP: 2 1/2 PVC Weight 36 lbs./ft.
Dia. 16 in. to 250 ft. depth Wall Thickness: inches or
Dia. _____ in. to _____ ft. depth gage No. 219

5. Type and color of material	From	To
clay sand and rock	0	136
medium to good	136	146
sandy clay and rock	146	167
medium to good	167	173
clay and sandy clay	173	196
medium sand	196	201
clay	201	206
medium to good	206	221
clay sandy	221	228
medium to good	228	235
soapstone	235	241
blue	241	250
<i>BROCK 735'</i>		

10. Screen: Manufacturer's name Lakewood Pipe
Type steel Dia. 16"
Casing 2" Length 90
Set between 145 ft. and 235 ft.
Gravel pack? Yes No Size range of material 3/8

11. Static water level: 125 ft. below land surface Date 4-26-77 mo./day/yr.

12. Pumping level below land surfaces:
149 ft. after 4 hrs. pumping 800 g.p.m.
190 ft. after 4 hrs. pumping 1800 g.p.m.
Estimated maximum yield 1800 g.p.m.

13. Water sample submitted: Yes No Date _____ mo./day/yr.

14. Well head completion:
 Pitless adapter 12 inches above grade

15. Well grouted? With: Neat cement Bentonite Concrete
Depth: From 0 ft. to 10 ft.

16. Nearest source of possible contamination: none
ft. _____ Direction _____ Type _____
Well disinfected upon completion? Yes No

17. Pump: Not installed
Manufacturer's name Peerless
Model number _____ HP 100 Volts _____
Length of drop pipe 240 ft. capacity 800 g.p.m.
Type:
 Submersible Turbine
 Jet Reciprocating
 Centrifugal Other

18. Elevation: _____

19. Remarks: _____

Topography:
 Hill
 Slope
 Upland
 Valley

20. Water well contractor's certification:
This well was drilled under my jurisdiction and this report is true to the best of my knowledge and belief. 248
Northwest Drilling Co. Inc
Business name Goodland, Kansas License No. _____
Address San Has
Signed Jan Has Date 5-24
Authorized representative

174 40' 35' SE NW SE