


1 LOCATION OF WATER WELL: Fraction ~~NE~~ ~~NE~~ ~~NE~~ Section Number ~~3~~ Township Number T ~~14~~ S Range Number R ~~41~~ E ~~10~~
 County: Wallace

Distance and direction from nearest town or city street address of well if located within city?
 1 S 6 W Sharon Springs
 2 WATER WELL OWNER: Charles Pearce
 RR#, St. Address, Box # :
 City, State, ZIP Code : Sharon Springs, Kansas 67758
 Board of Agriculture, Division of Water Resources
 Application Number:

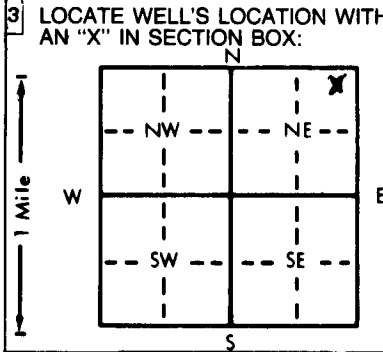

4 DEPTH OF COMPLETED WELL: 170 ft. ELEVATION:
 Depth(s) Groundwater Encountered 1. ft. 2. ft. 3. ft.
 WELL'S STATIC WATER LEVEL . 122 . . . ft. below land surface measured on mo/day/yr 4-20-83
 Pump test data: Well water was ft. after hours pumping gpm
 Est. Yield gpm: Well water was not tested ft. after hours pumping gpm
 Bore Hole Diameter . . . 8 . . . in. to . . . 170 . . . ft., and in. to ft.
 WELL WATER TO BE USED AS: 5 Public water supply 8 Air conditioning 11 Injection well
 Domestic 3 Feedlot 6 Oil field water supply 9 Dewatering 12 Other (Specify below)
 2 Irrigation 4 Industrial 7 Lawn and garden only 10 Observation well
 Was a chemical/bacteriological sample submitted to Department? Yes No ; If yes, mo/day/yr sample was submitted
 Water Well Disinfected? Yes No

5 TYPE OF BLANK CASING USED:
 1 Steel RMP (SR) 5 Wrought iron 8 Concrete tile CASING JOINTS: Glued Clamped
 2 PVC 4 ABS 6 Asbestos-Cement 9 Other (specify below) Welded
 7 Fiberglass Threaded
 Blank casing diameter 5 . . . in. to . . . 150 . . . ft., Dia in. to ft., Dia in. to ft.
 Casing height above land surface 18 . . . in., weight . . . 1.9/20 . . . lbs./ft. Wall thickness or gauge No. 14"
 TYPE OF SCREEN OR PERFORATION MATERIAL:
 1 Steel 3 Stainless steel 5 Fiberglass RMP (SR) 10 Asbestos-cement
 2 Brass 4 Galvanized steel 6 Concrete tile 9 ABS 11 Other (specify)
 12 None used (open hole)
 SCREEN OR PERFORATION OPENINGS ARE:
 1 Continuous slot 3 Mill slot 5 Gauzed wrapped Saw cut 11 None (open hole)
 2 Louvered shutter 4 Key punched 6 Wire wrapped 9 Drilled holes
 7 Torch cut 10 Other (specify)
 SCREEN-PERFORATED INTERVALS: From 150 . . . ft. to . . . 170 . . . ft., From ft. to ft.
 From ft. to ft., From ft. to ft.
 GRAVEL PACK INTERVALS: From 18 . . . ft. to . . . 170 . . . ft., From ft. to ft.
 From ft. to ft., From ft. to ft.

6 GROUT MATERIAL: Neat cement 2 Cement grout 3 Bentonite 4 Other
 Grout Intervals: From 4 . . . ft. to 18 . . . ft., From ft. to ft., From ft. to ft.
 What is the nearest source of possible contamination:
 1 Septic tank 4 Lateral lines 7 Pit privy 10 Livestock pens 14 Abandoned water well
 2 Sewer lines 5 Cess pool 8 Sewage lagoon 11 Fuel storage 15 Oil well/Gas well
 3 Watertight sewer lines 6 Seepage pit 9 Feedyard 12 Fertilizer storage 16 Other (specify below)
 13 Insecticide storage pasture
 Direction from well? How many feet?

FROM	TO	LITHOLOGIC LOG	FROM	TO	LITHOLOGIC LOG
0	19 01	Top Soil			
19	77	Sand Clay			
77	127 04	Sand & Sandy Clay Strips			
127	168 23	Sand Sand Rock Strips			
168	170 19	Open & Shale			

7 CONTRACTOR'S OR LANDOWNER'S CERTIFICATION: This water well was constructed, (2) reconstructed, or (3) plugged under my jurisdiction and was completed on (mo/day/year) 4-20-83 and this record is true to the best of my knowledge and belief. Kansas Water Well Contractor's License No. . . . 139 . . . This Water Well Record was completed on (mo/day/yr) . . . 7-7-83 . . . under the business name of Bartell Drilling . . . by (signature) Jaye Bartell
 INSTRUCTIONS: Use typewriter or ball point pen. PLEASE PRESS FIRMLY and PRINT clearly. Please fill in blanks, underline or circle the correct answers. Send top three copies to Kansas Department of Health and Environment, Division of Environment, Environmental Geology Section, Topeka, KS 66620. Send one to WATER WELL OWNER and retain one for your records.