

USE TYPEWRITER OR BALL POINT PEN-PRESS FIRMLY, PRINT CLEARLY.


WATER WELL RECORD
KSA 82a-1201-1215

BDB

Kansas Department of Health and Environment-Division of Environment (Water well Contractors) Topeka, Kansas 66620

1. Location of well: County Wallace Fraction NW 1/4 SE 1/4 NW 1/4 Section number 4 Township number T 14 S R 41 R/W Range number

2. Distance and direction from nearest town or city: 4 SHARON SPRINGS BC 1/4 S 1/4 E 3. Owner of well: CHARLES PEARCE
Street address of well location if in city: 7 W ~~LEITE~~ R.R. or street:
City, state, zip code: SHARON SPRINGS 67758

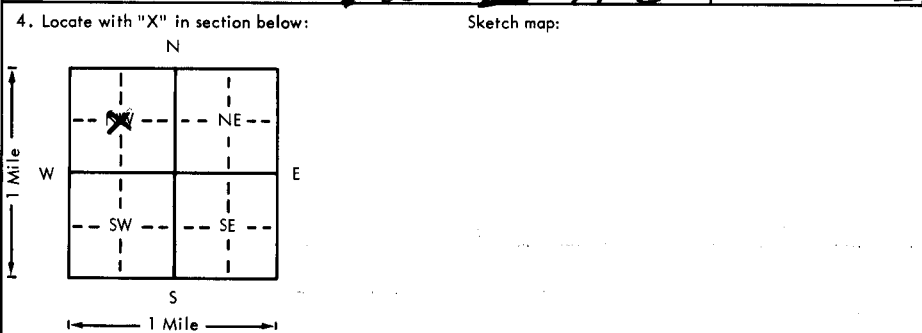

6. Bore hole dia. 38 in. Completion date 12-15-78
Well depth 181 ft.
7. Cable tool Rotary Driven Dug
 Hollow rod Jetted Bored Reverse rotary
8. Use: Domestic Public supply Industry
 Irrigation Air conditioning Stock
 Lawn Oil field water Other
9. Casing: Material Steel Height: Above or below
Threaded Welded Surface 12 in.
RMP PVC Weight 36 lbs./ft.
Dia 16 in. to 91 ft. depth Wall Thickness: inches or
Dia. in. to ft. depth Igage No. 219

5. Type and color of material	From	To
TOP SOIL	0	4
M GRAVEL, SANDY CLAY	4	62
CLAY	62	86
M GRAVEL	86	100
M GRAVEL, SANDSTONE	100	131
M GRAVEL	131	158
SANDY CLAY, SANDSTONE	158	167
M GRAVEL	167	173
OLBRE	173	181
(Use a second sheet if needed)		

10. Screen: Manufacturer's name W.H. BRAUN
Type LOWER Dia. 16
Slot/gauze 1/8 x 219 Length 90
Set between 91 ft. and 181 ft.
Gravel pack? YES Size range of material 1/4 x 9/8
11. Static water level: 58 ft. below land surface Date 11-3-78
12. Pumping level below land surfaces:
170 ft. after 5 hrs. pumping 1400 g.p.m.
 ft. after hrs. pumping g.p.m.
Estimated maximum yield 1500 g.p.m.
13. Water sample submitted: mo./day/yr.
 Yes No Date
14. Well head completion:
 Pitless adapter inches above grade
15. Well grouted? YES
With: Neat cement Bentonite Concrete
Depth: From 0 ft. to 10 ft.
16. Nearest source of possible contamination:
ft. Direction Type NATURE
Well disinfected upon completion? Yes No
17. Pump: Not installed
Manufacturer's name WESTERN LAND ROLLER
Model number 8H HP 90 Volts
Length of drop pipe 170 ft. capacity 1200 g.p.m.
Type:
 Submersible Turbine
 Jet Reciprocating
 Centrifugal Other

18. Elevation: Topography: Hill Slope Upland Valley
19. Remarks:

20. Water well contractor's certification:
This well was drilled under my jurisdiction and this report is true to the best of my knowledge and belief.
W.H. Drilling Co Inc 166
Business name License No.
Address Woodland Kansas
Signed Bill Chaffin Date 12-15-78
Authorized representative

14 410 4 1/4 1/4 1/4 1/4