


1 LOCATION OF WATER WELL: Fraction NW 1/4 SW 1/4 NW 1/4 Section Number 23 Township Number T 14S S Range Number R 41W E/W
 County: WALLACE

Distance and direction from nearest town or city street address of well if located within city?
 2 south and 6 east of Weskin

2 WATER WELL OWNER: Ernest Selzer
 RR#, St. Address, Box #: HC 2/Box 71 Board of Agriculture, Division of Water Resources
 City, State, ZIP Code: Sharon Spgs., KS 67758 Application Number:

3 LOCATE WELL'S LOCATION WITH AN "X" IN SECTION BOX:

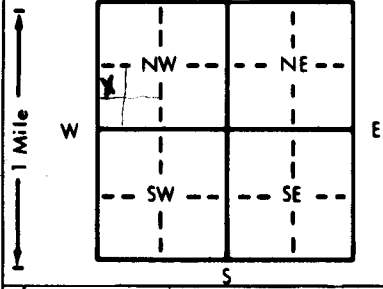

4 DEPTH OF COMPLETED WELL: 297 ft. ELEVATION:
 Depth(s) Groundwater Encountered 1. 202 ft. 2. ft. 3. ft.
 WELL'S STATIC WATER LEVEL: 202 ft. below land surface measured on mo/day/yr 7-19-91
 Pump test data: Well water was ft. after hours pumping gpm
 Est. Yield gpm: Well water was ft. after hours pumping gpm
 Bore Hole Diameter: 8 in. to 297 ft., and in. to ft.
 WELL WATER TO BE USED AS:
 1 Domestic 3 Feedlot 6 Oil field water supply 9 Dewatering 12 Other (Specify below)
 2 Irrigation 4 Industrial 7 Lawn and garden only 10 Monitoring well
 Was a chemical/bacteriological sample submitted to Department? Yes No X If yes, mo/day/yr sample was submitted
 Water Well Disinfected? Yes No

5 TYPE OF BLANK CASING USED:
 1 Steel 3 RMP (SR) 5 Wrought iron 8 Concrete tile CASING JOINTS: Glued Clamped
 2 PVC 4 ABS 6 Asbestos-Cement 9 Other (specify below) Welded
 7 Fiberglass Threaded
 Blank casing diameter: 5 in. to 277 ft., Dia. in. to ft., Dia. in. to ft.
 Casing height above land surface: 12 in., weight 200 lbs./ft. Wall thickness or gauge No. SDR 26

TYPE OF SCREEN OR PERFORATION MATERIAL:
 1 Steel 3 Stainless steel 5 Fiberglass 8 RMP (SR) 11 Other (specify)
 2 Brass 4 Galvanized steel 6 Concrete tile 9 ABS 12 None used (open hole)
 SCREEN OR PERFORATION OPENINGS ARE:
 1 Continuous slot 3 Mill slot 5 Gauzed wrapped 8 Saw cut 11 None (open hole)
 2 Louvered shutter 4 Key punched 6 Wire wrapped 9 Drilled holes
 7 Torch cut 10 Other (specify)
 SCREEN-PERFORATED INTERVALS: From 277 ft. to 297 ft. From ft. to ft.
 GRAVEL PACK INTERVALS: From 202 ft. to 297 ft. From ft. to ft.
 Returns From 20 ft. to 202 ft. From ft. to ft.

6 GROUT MATERIAL: 1 Neat cement 2 Cement grout 3 Bentonite 4 Other
 Grout Intervals: From 0 ft. to 20 ft., From ft. to ft., From ft. to ft.
 What is the nearest source of possible contamination: NONE IN VIEW
 1 Septic tank 4 Lateral lines 7 Pit privy 11 Fuel storage 14 Abandoned water well
 2 Sewer lines 5 Cess pool 8 Sewage lagoon 12 Fertilizer storage 15 Oil well/Gas well
 3 Watertight sewer lines 6 Seepage pit 9 Feedyard 13 Insecticide storage 16 Other (specify below)

Direction from well? How many feet?

FROM	TO	LITHOLOGIC LOG	FROM	TO	PLUGGING INTERVALS
0	60	Clay			
60	125	SAND & CLAY			
125	205	SAND + CLAY			
205	295	SAND + GRAVEL			
295	297	Shale			

7 CONTRACTOR'S OR LANDOWNER'S CERTIFICATION: This water well was (1) constructed, (2) reconstructed, or (3) plugged under my jurisdiction and was completed on (mo/day/year) 7-19-91 and this record is true to the best of my knowledge and belief. Kansas Water Well Contractor's License No. 484. This Water Well Record was completed on (mo/day/yr) 8-9-91 under the business name of Schaal Drilling, Co. by (signature) [Signature]