

WESKAN SE

USE TYPEWRITER OR BALL POINT PEN—PRESS FIRMLY, PRINT CLEARLY.

T R EW sec 1/4 1/4 1/4 No.

WATER WELL RECORD KSA 82a-1201-1215

Kansas State Dept. Of Health (Water Well Contractors) Forbes-Bldg. 740 Topeka, Kansas 66620


1 Location of well:	County <u>Wallace</u>	Township name <u>WeskanNE</u>	Fraction <u>NW 1/4 S 1/4 T 4</u>	Section number <u>23</u>	Town number <u>14</u>	Range number <u>41</u>
---------------------	--------------------------	----------------------------------	-------------------------------------	-----------------------------	--------------------------	---------------------------

Distance and direction from nearest town or city:
SHARON SPRINGS 45 5 1/2 W 1/2 S 1/4 E

Street address of well location if in city:
SHARON SPRINGS KANSAS

3 Owner of well: ERNEST SELZER

Address: SHARON SPRINGS KANSAS

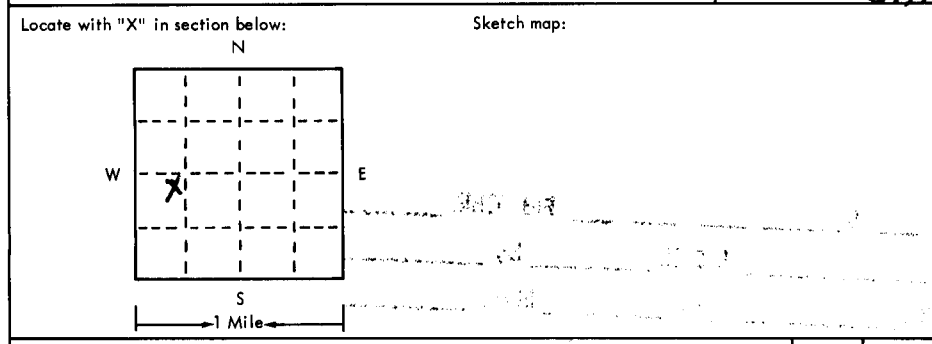

4 Well depth: 237 ft. Date of completion 8-21-75
Well diameter 26 in.

5 Cable tool Rotary Driven Dug
 Hollow rod Jetted Bored Reverse rotary

6 Use: Domestic Public supply Industry
 Irrigation Air conditioning Commercial
 Test well

7 Casing: Material Steel Height: above/below
Threaded Welded Surface 12 in.
Diam. 16 in. Weight 33 lbs./ft. L
16 in. to 144 ft. depth Drive shoe? Yes No
___ in. to ___ ft. depth

2	Type and color of material	From	To
	<u>M GRAVEL, SANDY CLAY, SANDSTONE</u>	<u>120</u>	<u>152</u>
	<u>M GRAVEL</u>	<u>152</u>	<u>157</u>
	<u>M GRAVEL, SANDY CLAY</u>	<u>157</u>	<u>178</u>
	<u>HARD SANDSTONE</u>	<u>178</u>	<u>184</u>
	<u>M GRAVEL, SANDY CLAY</u>	<u>184</u>	<u>193</u>
	<u>HARD SANDSTONE</u>	<u>193</u>	<u>194</u>
	<u>FINE SAND, SANDY CLAY, SANDSTONE</u>	<u>194</u>	<u>200</u>
	<u>FINE SAND</u>	<u>200</u>	<u>206</u>
	<u>HARD SANDSTONE</u>	<u>206</u>	<u>208</u>
	<u>FINE SAND, M GRAVEL</u>	<u>208</u>	<u>212</u>
	<u>CLAY</u>	<u>212</u>	<u>214</u>
	<u>GRAVEL</u>	<u>214</u>	<u>230</u>
	<u>Shree</u>	<u>230</u>	<u>234</u>
	<u>BROCK 230'</u>		

8 Screen:
Manufacturer W.A. BROWN
Type LUYER Dia. 16
Slot/gauze: 1/8" x 7/8" Length 90
Set between 144 ft. and 234 ft.
Fittings: 1/4" x 1/2"
Gravel pack Yes No Size range of material 4 1/2" x 8"

9 Static water level:
124 ft. below land surface Date 8-21-75

10 Pumping level below land surfaces:
195 ft. after 4 hrs. pumping 1400 g.p.m.
___ ft. after ___ hrs. pumping ___ g.p.m.
Estimated maximum yield 1800 g.p.m.

11 Water sample submitted:
 Yes No Date ___

12 Well head completion:
 Pitless adapter Inches above grade

13 Well grouted? Yes No
 Neat cement Bentonite ___
Depth: From 0 ft. to 10 ft.

14 Nearest source of possible contamination: Cess Pool
ft. 1300 Direction E Type Pool
Well disinfected upon completion? Yes No

15 Pump: Not installed
Manufacturer's name Western Land Rotten
Model number 8 m HP 100 Volts 440
Length of drop pipe 220 ft. capacity 1200 g.m.p.
Type:
 Submersible Turbine
 Jet Reciprocating
 Centrifugal Other

16 Remarks: elevation 3691 (TOPO)

Topography:
 Hill
 Slope
 Upland
 Valley

17 Water well contractor's certification:
This well was drilled under my jurisdiction and this report is true to the best of my knowledge and belief.
L & H Drilling Co. Inc. 166
Business name Woodland Kansas License No. 1200
Address Woodland Kansas
Signed Bill Coffey Date 9-2-75
Authorized representative