

WESKAN

T	R	EW	sec 1/4 1/4 1/4 No.
---	---	----	---------------------

USE TYPEWRITER OR BALL POINT PEN-PRESS FIRMLY, PRINT CLEARLY.

WATER WELL RECORD
KSA 82a-1201-1215


Kansas State Dept. Of Health
(Water Well Contractors)
Forbes-Bldg. 740
Topeka, Kansas 66620

CAA

1 Location of well:	County Wallace	Township name Weskan	Fraction NE-NE of SW	Section number 31	Town number 14	Range number 41
---------------------	-------------------	-------------------------	-------------------------	----------------------	-------------------	--------------------

Distance and direction from nearest town or city: 3 mi. south,
2 east, 2mi south of Weskan, Ks.
Street address of well location if in city:

3 Owner of well: Harold Cloyd
Address: Weskan, Kansas

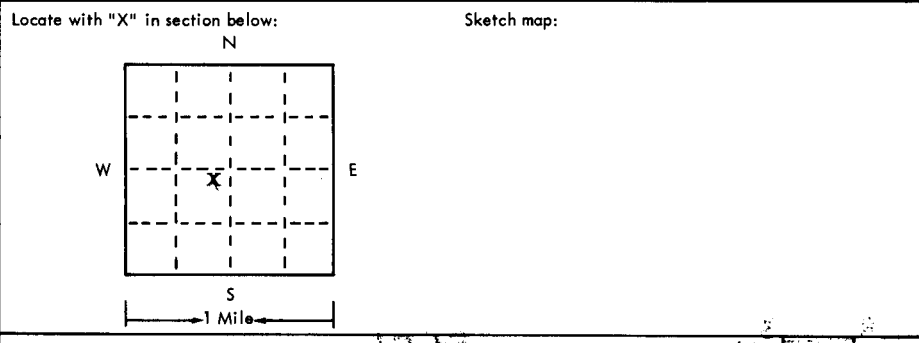

4 Well depth: 300 ft. Date of completion 3-13-75
Well diameter 28 in.

5 Cable tool Rotary Driven Dug
 Hollow rod Jetted Bored Reverse rotary

6 Use: Domestic Public supply Industry
 Irrigation Air conditioning Commercial
 Test well

7 Casing: Material steel Height: above/below
Threaded Welded Surface 18 in.
Diam. Weight ___ lbs./ft. ___
16 in. to 300 ft. depth Drive shoe? Yes No
___ in. to ___ ft. depth

2 Type and color of material	From	To
Overburden	0	140
Sand & Gravel & Clay Streaked	140	220
Coarse Sand	220	240
Course sand, thin clay & sandstone streaked	240	280
Coarse sand & clay	280	300
BRICK ?		
(use a second sheet if needed)		

8 Screen:
Manufacturer W. A. Brown
Type Free Flo Dia. 16
Slot/gauze slot Length 2"
Set between 200 ft. and 300 ft.
Fittings:
Gravel pack Yes No Size range of material 5/8

9 Static water level:
140 ft. below land surface Date 3-15-75

10 Pumping level below land surfaces: Not tested
___ ft. after ___ hrs. pumping ___ g.p.m.
___ ft. after ___ hrs. pumping ___ g.p.m.
Estimated maximum yield ___ g.p.m.

11 Water sample submitted:
 Yes No Date ___

12 Well head completion:
 Pitless adapter Inches above grade

13 Well grouted? Yes No
 Neat cement Bentonite ___
Depth: From ___ ft. to 10 ft.

14 Nearest source of possible contamination: None
ft. ___ Direction ___ Type ___
Well disinfected upon completion? Yes No

15 Pump: Not installed
Manufacturer's name Layne
Model number 25208K HP 150 Volts ___
Length of drop pipe 260 ft. capacity 1800 g.p.m.
Type:
 Submersible Turbine
 Jet Reciprocating
 Centrifugal Other

16 Remarks: elevation
3801 (TOPO)

Topography:
 Hill
 Slope
 Upland
 Valley

17 Water well contractor's certification:
This well was drilled under my jurisdiction and this report is true to the best of my knowledge and belief.
Ark Valley Pump & Supply 123
Business name License No. ___
Address 205 S. First Holly, Colo.
Signed W. Smith Date 10-30-75
Authorized representative

14 41 W 31 NE NE SW