

USE TYPEWRITER OR BALL POINT PEN-PRESS FIRMLY, PRINT CLEARLY.

WESKAN

WATER WELL RECORD  
KSA 82a-1201-1215

ADA


T	R	EW	sec 1/4 1/4 1/4 No.						

Kansas State Dept. Of Health  
(Water Well Contractors)  
Forbes-Bldg. 740  
Topeka, Kansas 66620

1 Location of well:	County Wallace	Township name	Fraction NE, SE, NE	Section number 31	Town number T14S	Range number R41W
---------------------	-------------------	---------------	------------------------	----------------------	---------------------	----------------------

Distance and direction from nearest town or city:  
Approx. 5 S & 3 E from  
Street address of well location if in city:  
Weskan

3 Owner of well: Alan Waugh  
Address: Sharon Springs, Ks

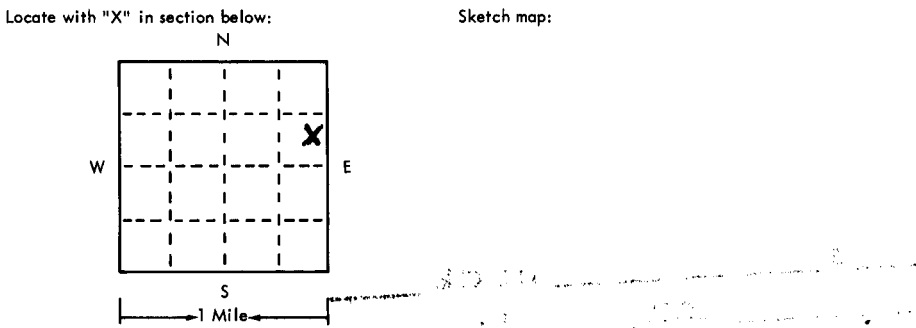

4 Well depth: 244 ft. Date of completion: 30 Apr 75  
Well diameter: 28 in.

5  Cable tool  Rotary  Driven  Dug  
 Hollow rod  Jetted  Bored  Reverse rotary

6 Use:  Domestic  Public supply  Industry  
 Irrigation  Air conditioning  Commercial  
 Test well

7 Casing: Material: steel Height: above/below  
Threaded  Welded  Surface 12 in.  
Diam. 16 in. Weight 37 lbs./ft.  
Set between 244 ft. and 244 ft. depth Drive shoe?  Yes  No

2	Type and color of material	From	To
	Well drilled near site of TH 7-74 (see attached), which is located 930' N. of SE cor of NE 1/4, Sec 31, 14-41, Wallace Co. BROOK 244'		

8 Screen:  
Manufacturer: Layne & L.B. Foster  
Type: Shutter Millalot 16"  
Slot/gauge: 1/8" Length: 60'  
Set between 184 ft. and 244 ft.  
Fittings: 1.2 - 9 mm  
Gravel pack  Yes  No Size range of material

9 Static water level: 178 ft. below land surface Date 4 Apr 75

10 Pumping level below land surfaces:  
188 ft. after 1 hrs. pumping 1016 g.p.m.  
206 ft. after 1 hrs. pumping 1950 g.p.m.  
Estimated maximum yield 2000 g.p.m.

11 Water sample submitted:  Yes  No Date

12 Well head completion:  Pitless adapter  Inches above grade

13 Well grouted?  Yes  No  
 Neat cement  Bentonite   
Depth: From 0 ft. to 10 ft.

14 Nearest source of possible contamination: Link  
ft. Direction Type  
Well disinfected upon completion?  Yes  No

15 Pump:  Not installed  
Manufacturer's name: Layne  
Model number: 12KH HP 150 Volts  
Length of drop pipe: 230 ft. capacity 1200 g.p.m.  
Type:  Submersible  Turbine  
 Jet  Reciprocating  
 Centrifugal  Other

16 Remarks: elevation  
Topography:  
 Hill  
 Slope  
 Upland  
 Valley

3617 (TOPO)

17 Water well contractor's certification:  
This well was drilled under my jurisdiction and this report is true to the best of my knowledge and belief.  
Layne Western Co 150  
Business name License No.  
Address: Garden City  
Signed: R.L. Hunt Date: 14 May 75  
Authorized representative

# TEST HOLE REPORT

## Layne-Western Company, Inc.



-WATER SUPPLY SERVICES SINCE 1924-

TEST DRILLING • WATER WELLS • PUMPS

P.O. Box 686 - W. Hwy. 50  
Garden City, Kansas 67846

Contract Name Alan Wough

**TEST HOLE**  
No. 7-74

Job No. K-467 Date 12-10-74

City Sharon Springs State Kansas

Driller Binns

Location of Test Hole 330' N of TH 2-74  
or 930' N of SE corner of


Elevation of Test Hole \_\_\_\_\_

$\frac{1}{4}$  NE  $\frac{1}{4}$  Sec. 31 of T 14S

Static Water Level 178'

R. 41W, Wallace Co., Kansas

Measured in well Hours After Completion

From	To	Description of Strata	Water Bearing
0	2	Top soil	
2	25	Fine to medium sand with caliche	
25	51	Fine to medium sand with fine to medium gravel and clay lenses	
51	70	Fine to medium sand with medium to coarse gravel loose	
70	115	Gray clay with fine sand lenses	
115	122	Fine to medium sand with gray and white clay lenses	
122	161	Fine to medium sand with fine to medium gravel	
161	181	Tan clay with fine sand lenses	
181	198	Fine to medium sand with medium gravel and clay lenses	
198	244	Fine to medium sand with medium to coarse gravel	
244	260	Black shale	

Remarks: **Best T.H.**