


1 LOCATION OF WATER WELL: Fraction E1/2 1/4 E1/2 1/4 NE 1/4 Section Number 34 Township Number T 14 S Range Number R 42 E/W
 County: Wallace

Distance and direction from nearest town or city street address of well if located within city?
4 3/4 Miles South of Weskan, Kansas

2 WATER WELL OWNER: Bonnie Hibbert Murfin Drilling, Inc.
 RR#, St. Address, Box #: 619 Stonestrow P. O. Box 661 Board of Agriculture, Division of Water Resources
 City, State, ZIP Code: Houston, TX 77057 Colby, Ks. 67701 Application Number: 960032

3 LOCATE WELL'S LOCATION WITH AN "X" IN SECTION BOX:

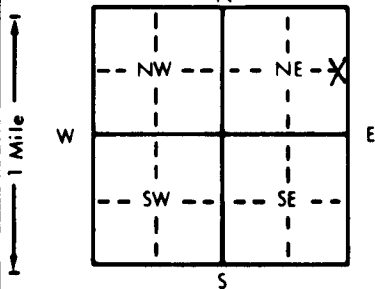

4 DEPTH OF COMPLETED WELL: 237 ft. ELEVATION: _____
 Depth(s) Groundwater Encountered 1. _____ ft. 2. _____ ft. 3. _____ ft.
 WELL'S STATIC WATER LEVEL: 190 ft. below land surface measured on mo/day/yr _____
 Pump test data: Well water was _____ ft. after _____ hours pumping _____ gpm
 Est. Yield _____ gpm: Well water was _____ ft. after _____ hours pumping _____ gpm
 Bore Hole Diameter: 8 in. to 237 ft., and _____ in. to _____ ft.
 WELL WATER TO BE USED AS:
 5 Public water supply 8 Air conditioning 11 Injection well
 1 Domestic 3 Feedlot 6 Oil field water supply 9 Dewatering 12 Other (Specify below)
 2 Irrigation 4 Industrial 7 Lawn and garden only 10 Monitoring well _____
 Was a chemical/bacteriological sample submitted to Department? Yes _____ No X _____; If yes, mo/day/yr sample was submitted _____
 Water Well Disinfected? Yes _____ No X _____

5 TYPE OF CASING USED:
 1 Steel 3 RMP (SR) 5 Wrought iron 8 Concrete tile CASING JOINTS: Glued X Clamped _____
 2 PVC 4 ABS 6 Asbestos-Cement 9 Other (specify below) Welded _____
 7 Fiberglass Threaded _____

Blank casing diameter: 4.5 in. to 197 ft., Dia _____ in. to _____ ft., Dia _____ in. to _____ ft.
 Casing height above land surface: 18 in., weight 2.38 lbs./ft. Wall thickness or gauge No. 248

TYPE OF SCREEN OR PERFORATION MATERIAL:
 1 Steel 3 Stainless steel 5 Fiberglass 7 PVC 10 Asbestos-cement
 2 Brass 4 Galvanized steel 6 Concrete tile 8 RMP (SR) 11 Other (specify) _____
 9 ABS 12 None used (open hole)

SCREEN OR PERFORATION OPENINGS ARE:
 1 Continuous slot 3 Mill slot 5 Gauzed wrapped 8 Saw cut 11 None (open hole)
 2 Louvered shutter 4 Key punched 6 Wire wrapped 9 Drilled Holes
 7 Torch cut 10 Other (specify) _____

SCREEN-PERFORATED INTERVALS: From 197 ft. to 237 ft., From _____ ft. to _____ ft.
 From _____ ft. to _____ ft., From _____ ft. to _____ ft.
 GRAVEL PACK INTERVALS: From 20 ft. to 237 ft., From _____ ft. to _____ ft.
 From _____ ft. to _____ ft., From _____ ft. to _____ ft.

6 GROUT MATERIAL: 1 Neat cement 2 Cement grout 3 Bentonite 4 Other _____
 Grout intervals: From 0 ft. to 20 ft., From _____ ft. to _____ ft., From _____ ft. to _____ ft.

What is the nearest source of possible contamination:
 1 Septic tank 4 Lateral lines 7 Pit privy 10 Livestock pens 14 Abandoned water well
 2 Sewer lines 5 Cess pool 8 Sewage lagoon 11 Fuel storage 15 Oil well/Gas well
 3 Watertight sewer lines 6 Seepage pit 9 Feedyard 12 Fertilizer storage 16 Other (specify below)
 13 Insecticide storage _____

Direction from well? 250' SW How many feet? 250'

FROM	TO	LITHOLOGIC LOG	FROM	TO	PLUGGING INTERVALS
0	2	Surface	109.5	127	Med. Sand w/Clay Strks.
2	4.5	Rock	127	130	Cemented Sand w/Clay Strks.
4.5	43	Caliche, Rock w/Clay Strks.	130	134	Sandy Clay w/Tight Sand Str.
43	53	Sandy Clay	134	140	Med. Sand w/a Few Clay Strks.
53	54	Caliche	140	188	Med. Sand & Gravel w/a Few Fine Clay Layers
54	61	Sandy Clay w/Caliche Strks.	188	195	Med. Sand w/Clay Strks.
61	65	Caliche	195	211	Med. Sand & Gravel
65	72	Med. Sand	211	220	Med. Sand & Gravel w/a Few Clay Strks.
72	85	Sandy Clay w/White Rock Strks.	220	225	Sticky Clay w/Sand Strks.
85	87	Caliche	225	234	Med. Sand w/a Few Clay Strks.
87	91	Cemented Sand	234	237	Black Shale
91	98	Med. Sand			
98	99.5	Sandy Clay			
99.5	101	Cemented Sand			
101	109.5	Med. Sand & Gravel			

7 CONTRACTOR'S OR LANDOWNER'S CERTIFICATION: This water well was (1) constructed, (2) reconstructed, or (3) plugged under my jurisdiction and was completed on (mo/day/year) 2-13-96 and this record is true to the best of my knowledge and belief. Kansas Water Well Contractor's License No. 554 This Water Well Record was completed on (mo/day/yr) 2-14-96 under the business name of Woofter Pump & Well, Inc. by (signature) [Signature]

INSTRUCTIONS: Use typewriter or ball point pen. PLEASE PRESS FIRMLY and PRINT clearly. Please fill in blanks, underline or circle the correct answers. Send top three copies to Kansas Department of Health and Environment, Bureau of Water, Topeka, Kansas 66620-0001. Telephone: 913-296-5545. Send one to WATER WELL OWNER and retain one for your records.