

WATER WELL PLUGGING RECORD Form WWC-5P

KSA 82a-1212

ID NO.

20442

1 LOCATION OF WATER WELL: County: Wallace	Fraction W ¼ 1/2 ¼ SE ¼ SE ¼	Section Number 12	Township Number 14 T S	Range Number 42 <input type="checkbox"/> E <input checked="" type="checkbox"/> W
---	---------------------------------	----------------------	---------------------------	---


Street/Rural Address of Well Location; if unknown, distance & direction from nearest town or intersection: If at owner's address, check here SOUTH OF WESKAN TO RD L 1 EAST, 1 SOUTH, 3/4 EAST, N TO WELL

Global Positioning Systems (GPS) information:
 Latitude: 38:50.700' (in decimal degrees)
 Longitude: 101.55.760 (in decimal degrees)
 Elevation: 3772'
 Horizontal Datum: WGS84, NAD83, NAD27
 Collection Method:

2 WATER WELL OWNER: TRACY COX
 RR#, St. Address, Box #: 295 WESKAN AVE
 City, State ZIP Code: WESKAN KS 67762

GPS unit (Make/Model: GARVIN
 Digital Map/Photo, Topographic Map, Land Survey
 Est. Accuracy: < 3 m, 3-5 m, 5-15 m, > 15 m

3 MARK WELL'S LOCATION WITH AN "X" IN SECTION BOX:

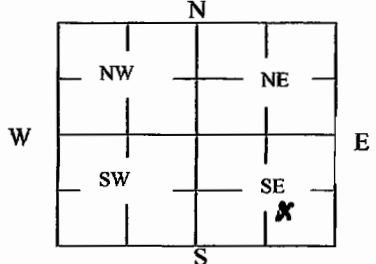

4 DEPTH OF WELL 306 **ft.**
WELL'S STATIC WATER LEVEL 248 **ft**
WELL WAS USED AS:
 Domestic Public Water Supply Dewatering
 Irrigation Oil Field Water Supply Monitoring
 Feedlot Domestic (Lawn & Garden) Injection Well
 Industrial Air Conditioning Other _____
 Was a chemical/bacteriological sample submitted to Department? Yes No

5 TYPE OF BLANK CASING USED:

Steel RMP (SR) Wrought Fiberglass Other (Specify below)
 PVC ABS Asbestos-Cement Concrete Tile

Blank casing diameter 16 in. Was casing pulled? Yes No If yes, how much 8'
 Casing height above or below land surface _____ in.

6 GROUT PLUG MATERIAL: Neat cement Cement grout Bentonite Other _____

Grout Plug Intervals: From 230 ft. to 225 ft., From 8 ft. to 7 ft., From _____ ft. to _____ ft.

What is the nearest source of possible contamination:
 Septic tank Seepage pit Fuel storage Other (specify below)
 Sewer lines Pit privy Fertilizer storage NONE
 Watertight sewer lines Sewage lagoon Insecticide storage _____
 Lateral lines Feedyard Abandoned water well Direction from well? _____
 Cess pool Livestock pens Oil well/Gas well How many feet? _____

FROM	TO	PLUGGING MATERIALS	FROM	TO	PLUGGING MATERIALS
306	230	WASHED GRAVEL & HTH			
230	225	10 BAGS HOLE PLUG			
225	8	NATIVE CLAY			
8	8	1/4" PLATE WELDED SOLID			
8	7	HOLE PLUG OVER CASING & AROUND BOREHOLE			
7	0	NATIVE CLAYS TO TOP			

7 CONTRACTOR'S OR LANDOWNER'S CERTIFICATION: This water well was plugged under my jurisdiction and was completed on (mo/day/year) 3-14-2017 and this record is true to the best of my knowledge and belief. Kansas Water Well Contractor's License No. 633. This Water Well Record was completed on (mo/day/year) 5-15-17 under the business name of DMW WELL & PUMP SERVICE by (signature) *Geary T Hudnell*

Send one white copy to Kansas Department of Health & Environment, Geology Section, 1000 SW Jackson Street, Ste. 420, Topeka, KS 66612-1367. Send one copy to WATER WELL OWNER and retain one for your records.
 Visit us at <http://www.kdheks.gov/waterwell/index.html> Telephone 785-296-5524.