

WESKAN

USE TYPEWRITER OR BALL POINT PEN-PRESS FIRMLY, PRINT CLEARLY.

T R EW sec 1/4 1/4 1/4 No.


WATER WELL RECORD  
KSA 82a-1201-1215

Kansas State Dept. Of Health  
(Water Well Contractors)  
Forbes-Bldg. 740  
Topeka, Kansas 66620

BAA

1 Location of well:	County	Township name	Fraction	Section number	Town number	Range number
	Wallace	Weskan	NE 1/4 NW 1/4	3	14	42

Distance and direction from nearest town or city: Weskan	3 Owner of well: MARVIN COY
Street address of well location if in city: 1/2 N 1/2 W	Address: WESKAN KANSAS

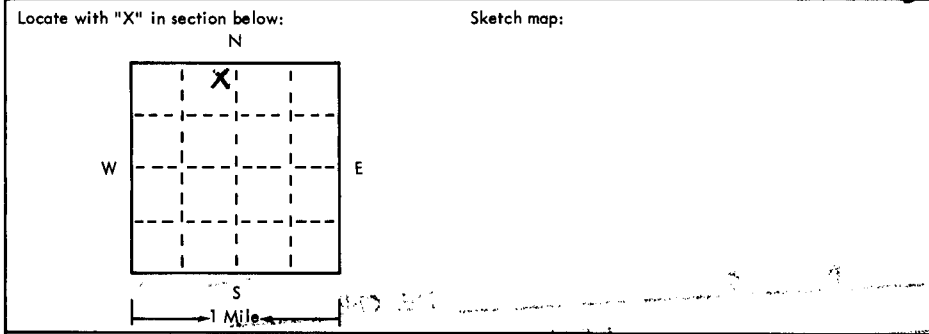

4 Well depth: 340 ft. Date of completion 2-26-75
Well diameter 26 in.
5 <input type="checkbox"/> Cable tool <input type="checkbox"/> Rotary <input type="checkbox"/> Driven <input type="checkbox"/> Dug <input type="checkbox"/> Hollow rod <input type="checkbox"/> Jetted <input type="checkbox"/> Bored <input checked="" type="checkbox"/> Reverse rotary
6 Use: <input type="checkbox"/> Domestic <input type="checkbox"/> Public supply <input type="checkbox"/> Industry <input checked="" type="checkbox"/> Irrigation <input type="checkbox"/> Air conditioning <input type="checkbox"/> Commercial <input type="checkbox"/> Test well
7 Casing: Material Steel Height: above/below Threaded <input type="checkbox"/> Welded <input checked="" type="checkbox"/> Surface 12 in. Diam. 16 in. to 340 ft. depth Drive shoe? <input type="checkbox"/> Yes <input checked="" type="checkbox"/> No Weight 33 lbs./ft. 1 in. to ___ ft. depth!

2	Type and color of material	From	To
	M GRAVEL, SANDY CLAY	134	144
	GRAVEL, SANDY CLAY	144	153
	M GRAVEL, SANDY CLAY	153	163
	GRAVEL, SANDY CLAY	163	173
	GRAVEL	173	191
	GRAVEL, SANDY CLAY	191	201
	GRAVEL, SANDY CLAY SANDSTONE	201	254
	M GRAVEL	254	302
	GRAVEL, SANDY CLAY, SANDSTONE	302	312
	M GRAVEL	312	336
	SHALE	336	340
	BROOK 336'		

8 Screen: Manufacturer W.A. BROWN Type LUGER Dia. 16 Slot/gauze 1/8 - 7 Length 130 Set between 206 ft. and 336 ft. Fittings: Gravel pack <input checked="" type="checkbox"/> Yes <input type="checkbox"/> No Size range of material 1/4 x 5/8
9 Static water level: 145 ft. below land surface Date 2-27-75
10 Pumping level below land surfaces: 185 ft. after 4 hrs. pumping 1600 g.p.m. ___ ft. after ___ hrs. pumping ___ g.p.m. Estimated maximum yield 2000 g.p.m.
11 Water sample submitted: <input type="checkbox"/> Yes <input checked="" type="checkbox"/> No Date ___
12 Well head completion: <input type="checkbox"/> Pitless adapter <input type="checkbox"/> Inches above grade
13 Well grouted? <input checked="" type="checkbox"/> Yes <input type="checkbox"/> No <input checked="" type="checkbox"/> Neat cement <input type="checkbox"/> Bentonite <input type="checkbox"/> ___ Depth: From 0 ft. to 10 ft.
14 Nearest source of possible contamination: ft. ___ Direction ___ Type None Well disinfected upon completion? <input type="checkbox"/> Yes <input type="checkbox"/> No
15 Pump: <input type="checkbox"/> Not installed Manufacturer's name Western Land Roller Model number 1014 HP 200 Volts 440 Length of drop pipe 300 ft. capacity 2000 g.p.m. Type: <input type="checkbox"/> Submersible <input type="checkbox"/> Turbine <input type="checkbox"/> Jet <input type="checkbox"/> Reciprocating <input type="checkbox"/> Centrifugal <input type="checkbox"/> Other

16 Remarks: elevation

3842 (TOPO)

Topography:  
 Hill  
 Slope  
 Upland  
 Valley

17 Water well contractor's certification:  
This well was drilled under my jurisdiction and this report is true to the best of my knowledge and belief.  
A.H. Drilling Co Inc 166  
Business name License No.  
Address Hopkirk Kansas  
Signed Bill Dufford Date 2-11-75  
Authorized representative