

USE TYPEWRITER OR BALL POINT PEN—PRESS FIRMLY, PRINT CLEARLY.

WESKAN

T R EW sec 1/4 1/4 1/4 No.

WATER WELL RECORD
KSA 82a-1201-1215


Kansas State Dept. Of Health
(Water Well Contractors)
Forbes-Bldg. 740
Topeka, Kansas 66620

ACC

1 Location of well: County Wallace Township name Weskan Fraction SW 1/4 NE 1/4 Section number 4 Town number T14S Range number R42W

Distance and direction from nearest town or city: Weskan
Street address of well location if in city: 1/2 N 1 1/2 W 1/2 S

3 Owner of well: Gene Walker
Address: Weskan Kansas

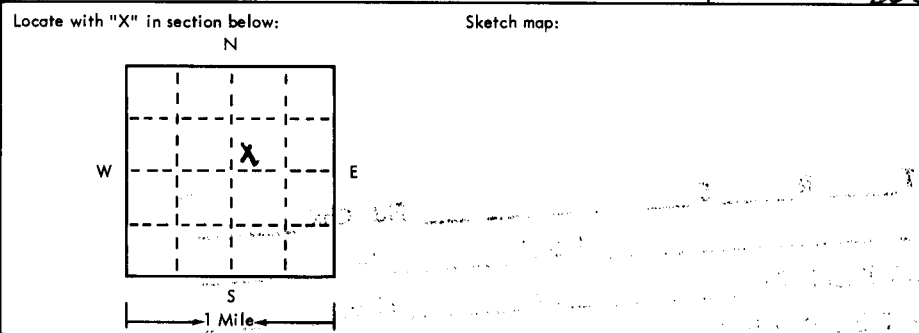

4 Well depth: 381 ft. Date of completion 3-9-75
Well diameter 26 in.

5 Cable tool Rotary Driven Dug
 Hollow rod Jetted Bored Reverse rotary

6 Use: Domestic Public supply Industry
 Irrigation Air conditioning Commercial
 Test well

7 Casing: Material Steel Height: above 4 ft.
Threaded Welded Surface 12 in.
Diam. 33 lbs./ft. 1
1/2 in. to 247 ft. depth Drive shoe? Yes No
1/2 in. to — ft. depth

2	Type and color of material	From	To
	M GRAVEL	142	151
	CLAY	151	172
	M GRAVEL, SANDY CLAY	172	175
	FINE SAND, M GRAVEL	175	191
	M GRAVEL, SANDY CLAY	191	217
	SANDY CLAY	217	223
	M GRAVEL	223	254
	M GRAVEL, SANDY CLAY	254	260
	SANDY CLAY	260	264
	M GRAVEL	264	276
	SANDY CLAY SANDSTONE	276	285
	M GRAVEL, SANDY CLAY	285	306
	M GRAVEL, TRUSS CLAY	306	335
	M GRAVEL	335	377
	Cable <u>BROCK 377'</u>	377	381

8 Screen: Manufacturer W A BROWN
Type LUVER Dia. 1 1/2"
Slot/gauze 1/8-7 Length 130'
Set between 242 ft. and 322 ft.
Fittings: Gravel pack Yes No Size range of material 1/2" - 3/8"

9 Static water level: 165 ft. below land surface Date 3-11-75

10 Pumping level below land surfaces:
220 ft. after 5 hrs. pumping 1200 g.p.m.
— ft. after — hrs. pumping — g.p.m.
Estimated maximum yield 2000 g.p.m.

11 Water sample submitted:
 Yes No Date —

12 Well head completion:
 Pitless adapter Inches above grade

13 Well grouted? Yes No
 Neat cement Bentonite —
Depth: From 0 ft. to 10 ft.

14 Nearest source of possible contamination:
ft. — Direction — Type NONE
Well disinfected upon completion? Yes No

15 Pump: Not installed
Manufacturer's name Western Land Roller
Model number 814 HP 100 Volts 440
Length of drop pipe 300 ft. capacity 1200 g.p.m.
Type: Submersible Turbine
 Jet Reciprocating
 Centrifugal Other

16 Remarks: elevation 3861 (TOPO)

Topography:
 Hill
 Slope
 Upland
 Valley

17 Water well contractor's certification:
This well was drilled under my jurisdiction and this report is true to the best of my knowledge and belief.
SW Drilling Co Inc License No. 166
Business name Special Kansas
Address Bill Clifford
Signed Bill Clifford Date 4-1-75
Authorized representative