


USE TYPEWRITER OR BALL POINT PEN-PRESS FIRMLY, PRINT CLEARLY.

BAA WATER WELL RECORD
KSA 82a-1201-1215

Kansas Department of Health and Environment-Division of Environment
(Water well Contractors)
Topeka, Kansas 66620

1. Location of well: County Wallace raction NE 1/4 CNE 1/4 NW 1/4 Section number 7 Township number T 14 S R 42 Range number E 14

2. Distance and direction from nearest town or city: 3W, 1/4 S, 1/2W, Weskan, Kansas
Street address of well location if in city:
3. Owner of well: Harold Ellis
R.R. or street:
City, state, zip code: Coldwater, Kansas

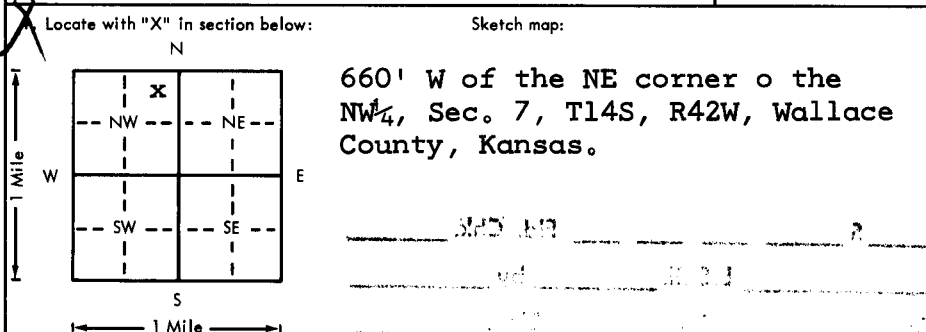

6. Bore hole dia. 28 in. Completion date 1-28-77
Well depth 347 ft.

7. Cable tool Rotary Driven Dug
 Hollow rod Jetted Bored Reverse rotary

8. Use: Domestic Public supply Industry
 Irrigation Air conditioning Stock
 Lawn Oil field water Other

9. Casing: Material stl. Height: Above or below
Threaded Welded Surface 12 in.
RMP: PVC Weight 37 lbs./ft.
Dia. 16 in. to 202 ft. depth Wall Thickness: inches or
Dia. in. to ft. depth gage No. 219

5. Type and color of material	From	To
Top soil	0	4
Tan clay sand streaks	4	104
Fine to coarse sand	104	128
Tan clay sand streaks	128	212
Coarse sand fine to coarse gravel	212	242
Tan clay	242	253
Coarse sand fine to medium gravel tan clay st	253	347
Yellow clay black shale	347	360
(Use a second sheet if needed)		

10. Screen: Manufacturer's name Foster, Cook
Doerr
Type Louvered Dia. 16"
Slot/gauze W/W 1/8 Length 145
Set between 202 ft. and 347 ft.
202 ft. and ft.
Gravel pack? Size range of material 2-4 mm

11. Static water level: 156 ft. below land surface Date 8-10-76 mo./day/yr.

12. Pumping level below land surfaces:
168 ft. after 1/2 hrs. pumping 1613 g.p.m.
184 ft. after 1 hrs. pumping 2740 g.p.m.
Estimated maximum yield 4000 g.p.m.

13. Water sample submitted: mo./day/yr.
Yes No Date

14. Well head completion:
 Pitless adapter Inches above grade

15. Well grouted? yes
With: Neat cement Bentonite Concrete
Depth: From 0 ft. to 10 ft.

16. Nearest source of possible contamination: unk
ft. Direction Type
Well disinfected upon completion? Yes No

17. Pump: Not installed
Manufacturer's name Layne & Bowler
Model number 12TL HP Volts
Length of drop pipe 280 ft. capacity 1400 g.p.m.
Type:
 Submersible Turbine
 Jet Reciprocating
 Centrifugal Other

18. Elevation:
Topography:
 Hill
 Slope
 Upland
 Valley

19. Remarks:
BROCK 347

20. Water well contractor's certification:
This well was drilled under my jurisdiction and this report is true to the best of my knowledge and belief.
Layne-Western Co., Inc. 102
Business name License No.
Address Garden City, Ks.
Signed [Signature] Date 14 Feb 77
Authorized representative

T 14 S R 42 E 14