


USE TYPEWRITER OR BALL POINT PEN - PRESS FIRMLY
PRINT CLEARLY

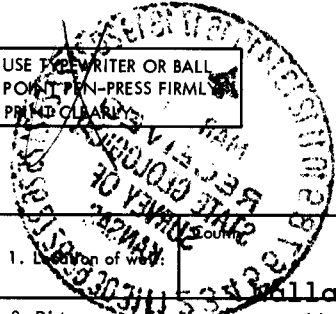

WESKAN


WATER WELL RECORD
KSA 82a-1201-1215

Kansas Department of Health and Environment - Division of Environment
(Water well Contractors)
Topeka, Kansas 66620

BAA

1. Location of well: Wallace NE 1/4 NE 1/4 NW 1/4 Section number 26 Township number T 14 S R 42 E/W Range number

2. Distance and direction from nearest town or city: 3 1/2 miles south, 1/2 east of Weskan, Kansas.
Street address of well location if in city:
3. Owner of well: Edward Waugh
R.R. or street:
City, state, zip code: Weskan, Kansas

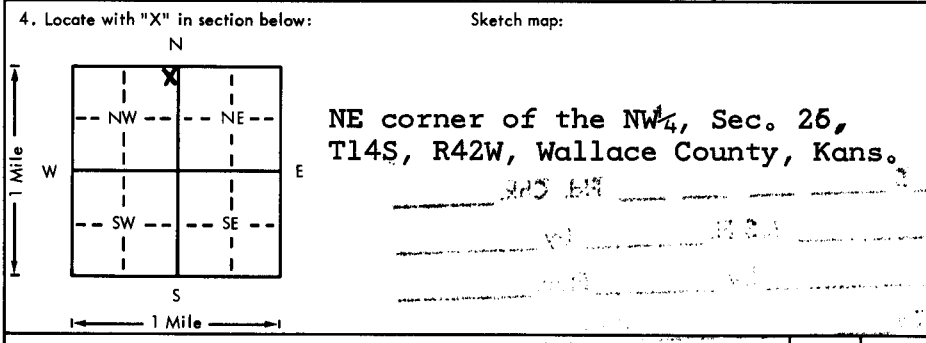

6. Bore hole dia. 28 in. Completion date
Well depth 316 ft. 2/18/77

7. Cable tool Rotary Driven Dug
Hollow rod Jetted Bored Reverse rotary

8. Use: Domestic Public supply Industry
 Irrigation Air conditioning Stock
Lawn Oil field water Other

9. Casing: Material stl Height: Above or below
Threaded Welded Surface 12 in.
RMP PVC Weight 37 lbs./ft.
Dia. 1.6 in. to 120 ft. depth Wall Thickness: inches or
Dia. in. to ft. depth Gage No. 219

5. Type and color of material	From	To
Top soil	0	20
Fine to medium sand	20	44
Fine to coarse sand, fine gravel	44	83
Very fine sand	83	119
Fine sand	119	140
Fine to medium sand	140	170
Tan clay	170	180
Fine to coarse sand	180	214
Tan clay, sand streaks	214	230
Fine to coarse sand	230	266
Fine to coarse sand	266	286
Fine to coarse sand	286	316
Black shale	316	340
BRACK 316'		

10. Screen: Manufacturer's name Foster, Cook, Doerr
Type Millslot, wwp dia. 16"
Slot/gauze 1/8" Length 196'
Set between 120 ft. and 316 ft.
Gravel pack? Size range of material 3.0mm

11. Static water level: mo./day/yr.
128 ft. below land surface Date 12/20/76

12. Pumping level below land surfaces:
162 ft. after 1/2 hrs. pumping 1963 g.p.m.
174 ft. after 1 hrs. pumping 2816 g.p.m.
Estimated maximum yield 3000 g.p.m.

13. Water sample submitted: mo./day/yr.
Yes No Date

14. Well head completion:
Pitless adapter Inches above grade

15. Well grouted?
With: Neat cement Bentonite Concrete
Depth: From 0 ft. to 10 ft.

16. Nearest source of possible contamination: unk
ft. Direction Type
Well disinfected upon completion? Yes No

17. Pump: Not installed
Manufacturer's name Layne & Bowler
Model number 12 TH HP 125 Volts
Length of drop pipe 220 ft. capacity 1800 g.p.m.
Type:
 Submersible Turbine
 Jet Reciprocating
 Centrifugal Other

18. Elevation:
Topography:
 Hill
 Slope
 Upland
 Valley

19. Remarks:
3790 (TOP)

20. Water well contractor's certification:
This well was drilled under my jurisdiction and this report is true to the best of my knowledge and belief.
Layne-Western Co., Inc 102
Business name License No.
Address Garden City, Kansas
Signed *R. L. Linnert* Date 22 Feb 77
Authorized representative

174 420 26 NE NE NW
T R Sec 1/4 1/4 1/4