


1 LOCATION OF WATER WELL: County: Wallace Fraction: SE 1/4 SE 1/4 NW 1/4 Section Number: 32 Township Number: T 19 S Range Number: R 42 EW

Distance and direction from nearest town or city street address of well if located within city?  
3 West, 4 1/2 South WESKIN KS.

2 WATER WELL OWNER: DANNY WELCH  
 RR#, St. Address, Box #: Rt 1, Box 2A  
 City, State, ZIP Code: Weskin, KS 67762  
 Board of Agriculture, Division of Water Resources  
 Application Number:

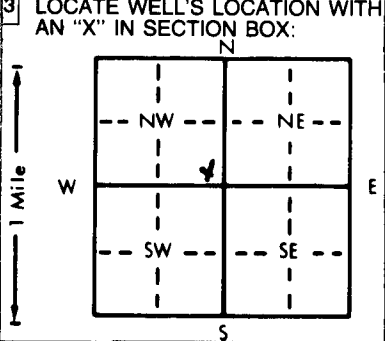

4 DEPTH OF COMPLETED WELL: 265 ft. ELEVATION: \_\_\_\_\_  
 Depth(s) Groundwater Encountered 1. 191 ft. 2. \_\_\_\_\_ ft. 3. \_\_\_\_\_ ft.  
 WELL'S STATIC WATER LEVEL: 191 ft. below land surface measured on mo/day/yr \_\_\_\_\_  
 Pump test data: Well water was \_\_\_\_\_ ft. after \_\_\_\_\_ hours pumping \_\_\_\_\_ gpm  
 Est. Yield: 15 gpm Well water was \_\_\_\_\_ ft. after \_\_\_\_\_ hours pumping \_\_\_\_\_ gpm  
 Bore Hole Diameter: 8 in. to 265 ft., and \_\_\_\_\_ in. to \_\_\_\_\_ ft.  
 WELL WATER TO BE USED AS:  
 1 Domestic  3 Feedlot  6 Oil field water supply  9 Dewatering  12 Other (Specify below)  
 2 Irrigation  4 Industrial  7 Lawn and garden only  10 Monitoring well  
 Was a chemical/bacteriological sample submitted to Department? Yes \_\_\_\_\_ No  If yes, mo/day/yr sample was submitted \_\_\_\_\_  
 Water Well Disinfected?  Yes  No

5 TYPE OF BLANK CASING USED:  
 1 Steel  3 RMP (SR)  5 Wrought iron  8 Concrete tile CASING JOINTS:  Glued  Clamped  
 2 PVC  4 ABS  6 Asbestos-Cement  9 Other (specify below)  Welded  
 Blank casing diameter \_\_\_\_\_ in. to 245 ft., Dia \_\_\_\_\_ in. to \_\_\_\_\_ ft., Dia \_\_\_\_\_ in. to \_\_\_\_\_ ft.  
 Casing height above land surface: 12 in., weight 200 lbs./ft. Wall thickness or gauge No. 8/22  
 TYPE OF SCREEN OR PERFORATION MATERIAL:  
 1 Steel  3 Stainless steel  5 Fiberglass  7 PVC  10 Asbestos-cement  
 2 Brass  4 Galvanized steel  6 Concrete tile  9 ABS  11 Other (specify) \_\_\_\_\_  
 12 None used (open hole)  
 SCREEN OR PERFORATION OPENINGS ARE:  
 1 Continuous slot  3 Mill slot  5 Gauzed wrapped  8 Saw cut  11 None (open hole)  
 2 Louvered shutter  4 Key punched  6 Wire wrapped  9 Drilled holes  
 7 Torch cut  10 Other (specify) \_\_\_\_\_  
 SCREEN-PERFORATED INTERVALS: From 245 ft. to 265 ft., From \_\_\_\_\_ ft. to \_\_\_\_\_ ft.  
 GRAVEL PACK INTERVALS: From 190 ft. to 265 ft., From \_\_\_\_\_ ft. to \_\_\_\_\_ ft.  
 8-12 Silica From 20 ft. to 190 ft., From \_\_\_\_\_ ft. to \_\_\_\_\_ ft.  
 FILL SAND

6 GROUT MATERIAL:  1 Neat cement  2 Cement grout  3 Bentonite  4 Other \_\_\_\_\_  
 Grout intervals: From 0 ft. to 20 ft., From \_\_\_\_\_ ft. to \_\_\_\_\_ ft., From \_\_\_\_\_ ft. to \_\_\_\_\_ ft.  
 What is the nearest source of possible contamination:  
 1 Septic tank  4 Lateral lines  7 Pit privy  10 Livestock pens  14 Abandoned water well  
 2 Sewer lines  5 Cess pool  8 Sewage lagoon  11 Fuel storage  15 Oil well/Gas well  
 3 Watertight sewer lines  6 Seepage pit  9 Feedyard  12 Fertilizer storage  16 Other (specify below)  
 13 Insecticide storage  
 Direction from well? NONE IN VIEW How many feet?

FROM	TO	LITHOLOGIC LOG	FROM	TO	PLUGGING INTERVALS
0	20	Clay			
20	40	Clay and sand			
40	80	gravel, sand and clay			
80	140	gravel, sand and clay			
140	200	gravel, clay			
200	210	clay			
210	265	gravel and sand			
265		Shale			

7 CONTRACTOR'S OR LANDOWNER'S CERTIFICATION: This water well was  (1) constructed,  (2) reconstructed, or  (3) plugged under my jurisdiction and was completed on (mo/day/year) 8-27-92 and this record is true to the best of my knowledge and belief. Kansas Water Well Contractor's License No. 484 This Water Well Record was completed on (mo/day/yr) 9-8-92 under the business name of Schaal Drilling, Co. by (signature) Palm Schaal