

USE TYPEWRITER OR BALL POINT PEN-PRESS FIRMLY, PRINT CLEARLY.


WATER WELL RECORD  
KSA 82a-1201-1215

Kansas Department of Health and Environment-Division of Environment (Water well Contractors) Topeka, Kansas 66620

*AISC*

1. Location of well: County WALLACE Fraction SW 1/4 SE 1/4 NE 1/4 Section number 36 Township number T 14 S R 43 EW

2. Distance and direction from nearest town or city: Weskan  
Street address of well location if in city: 4 W 5 1/2 S 1/4 W  
3. Owner of well: LAWRENCE PURVIS  
R.R. or street:  
City, state, zip code: WESKAN KANSAS 67762

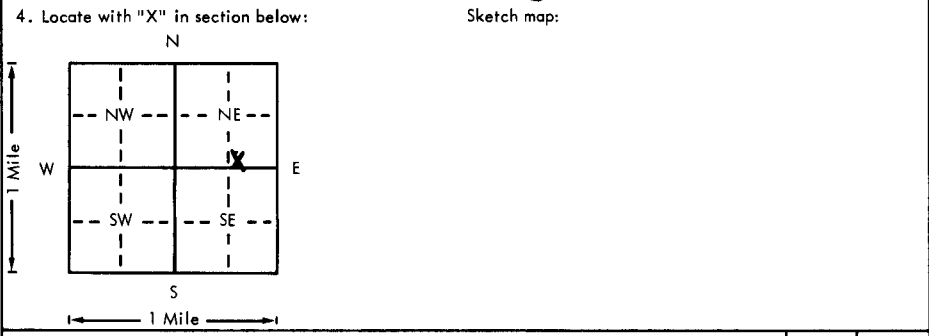

6. Bore hole dia. 2 1/2 in. Completion date 6-20-79  
Well depth 315 ft.  
7.  Cable tool  Rotary  Driven  Dug  
 Hollow rod  Jetted  Bored  Reverse rotary  
8. Use:  Domestic  Public supply  Industry  
 Irrigation  Air conditioning  Stock  
 Lawn  Oil field water  Other  
9. Casing: Material Steel Height: Above or below  
Threaded  Welded  Surface 12 in.  
RMP  PVC  Weight 36 lbs./ft.  
Dia. 1 1/2 in. to 2 1/2 ft. depth Wall Thickness: inches or  
Dia.  in. to  ft. depth gage No. 219

5. Type and color of material	From	To
Top Soil	0	4
Clay, Fine Sand	4	90
Sandy Clay, GRAVEL	90	170
M GRAVEL	170	174
Sandy Clay	174	181
M GRAVEL	181	186
Sandy Clay	186	198
M GRAVEL	198	220
Sandy Clay	220	223
M GRAVEL	223	244
Sandy Clay	244	250
M GRAVEL	250	271
M GRAVEL Sandy Clay	271	297
M GRAVEL	297	311
Debre	311	315

10. Screen: Manufacturer's name W. A. BROWN  
Type Layer Dia. 16  
Slot/gauze 1/8 x .219 Length 100  
Set between 215 ft. and 315 ft.  
ft. and 315 ft.  
Gravel pack? YES Size range of material 4x12  
11. Static water level: 174 ft. below land surface Date 6-15-79 mo./day/yr.  
12. Pumping level below land surfaces:  
195 ft. after 3 hrs. pumping 1200 g.p.m.  
ft. after        hrs. pumping        g.p.m.  
Estimated maximum yield 3000 g.p.m.  
13. Water sample submitted:        mo./day/yr.  
 Yes  No Date         
 Well head completion:  
 Pitless adapter        inches above grade  
15. Well grouted? yes  
With:  Neat cement  Bentonite  Concrete  
Depth: From 0 ft. to 10 ft.  
 Nearest source of possible contamination:  
ft.        Direction        Type NONE  
Well disinfected upon completion?  Yes  No  
17. Pump: Not installed  
Manufacturer's name BYRON JACKSON  
Model number 10 1/2 HP 175 Volts         
Length of drop pipe 310 ft. capacity 1000 g.p.m.  
Type:  
 Submersible  Turbine  
 Jet  Reciprocating  
 Centrifugal  Other

18. Elevation:  
Topography:  
 Hill  
 Slope  
 Upland  
 Valley  
19. Remarks:  
BROCK 311'  
(Use a second sheet if needed)

20. Water well contractor's certification:  
This well was drilled under my jurisdiction and this report is true to the best of my knowledge and belief  
John Dillingham 106  
Business name        License No.         
Address         
Signed Bill Dillingham Date 7-9-79  
Authorizing representative

14 430  
36 SW SE NE  
1/4 1/4 1/4