

WATER WELL RECORD

Form WWC-5

Division of Water Resources; App. No.

1 LOCATION OF WATER WELL: County: <u>SALINE</u>		Fraction <u>NE</u> $\frac{1}{4}$ <u>NW</u> $\frac{1}{4}$ <u>SW</u> $\frac{1}{4}$		Section Number <u>13</u>	Township Number <u>T 14 S</u>	Range Number <u>R 5 E</u>	
Distance and direction from nearest town or city street address of well if located within city? <u>440 SANTA FE SALINA, KS 67401</u>				Global Positioning Systems (decimal degrees, min. of 4 digits) Latitude: <u>N 38° 49.577</u> Longitude: <u>W 97° 36.534</u> Elevation: _____ Datum: <u>WGS 84</u> Data Collection Method: <u>GPS</u>	
2 WATER WELL OWNER: RR#, St. Address, Box # City, State, ZIP Code <u>KDHE - DFRTF</u> <u>1000 SW Jackson Street Suite 420</u> <u>Topeka, KS 66612-1367</u>	
3 LOCATE WELL'S LOCATION WITH AN "X" IN SECTION BOX: N W E S X		4 DEPTH OF COMPLETED WELL <u>50</u> ft. Depth(s) Groundwater Encountered (1) <u>999</u> ft. (2) _____ ft. (3) _____ ft. WELL'S STATIC WATER LEVEL _____ ft. below land surface measured on mo/day/yr. _____ Pump test data: Well water was _____ ft. after _____ hours pumping _____ gpm Est. Yield <u>NA</u> gpm: Well water was _____ ft. after _____ hours pumping _____ gpm WELL WATER TO BE USED AS: 5 Public water supply 8 Air conditioning 11 Injection well 1 Domestic 3 Feedlot 6 Oil field water supply 9 Dewatering 12 Other (Specify below) 2 Irrigation 4 Industrial 7 Domestic (lawn& garden) <u>10</u> Monitoring well Was a chemical/bacteriological sample submitted to Department? Yes _____ No <u>X</u> If yes, mo/day/yr Sample was submitted _____ Water well disinfected? Yes _____ No <u>X</u>	
5 TYPE OF CASING USED: 1 Steel 3 RMP (SR) 6 Asbestos-Cement 9 Other (specify below) CASING JOINTS: Glued _____ Clamped _____ <u>2 PVC</u> 4 ABS 7 Fiberglass _____ Welded _____ Threaded <u>YES</u> Blank casing diameter <u>2</u> " in. to <u>35</u> " ft., Diameter _____ in. to _____ ft., Diameter _____ in. to _____ ft. Casing height above land surface <u>4</u> " in. Weight <u>SCH 40</u> lbs./ft. Wall thickness or gauge No. _____ TYPE OF SCREEN OR PERFORATION MATERIAL: 1 Steel 3 Stainless Steel 5 Fiberglass <u>7 PVC</u> 9 ABS 11 Other (Specify) _____ 2 Brass 4 Galvanized Steel 6 Concrete tile 8 RM (SR) 10 Asbestos-Cement 12 None used (open hole) SCREEN OR PERFORATION OPENINGS ARE: 1 Continuous slot <u>3 Mill slot</u> 5 Gauzed wrapped 7 Torch cut 9 Drilled holes 11 None (open hole) 2 Louvered shutter 4 Key punched 6 Wire wrapped 8 Saw Cut 10 Other (specify) _____ SCREEN-PERFORATED INTERVALS: From <u>50</u> ft. to <u>35</u> ft., From _____ ft. to _____ ft. GRAVEL PACK INTERVALS: From <u>50</u> ft. to <u>31</u> ft., From _____ ft. to _____ ft. From _____ ft. to _____ ft., From _____ ft. to _____ ft.	
6 GROUT MATERIAL: 1 Neat cement 2 Cement grout <u>3 Bentonite</u> 4 Other _____ Grout Intervals: From <u>50</u> ft. to <u>31</u> ft., From _____ ft. to _____ ft., From _____ ft. to _____ ft. What is the nearest source of possible contamination: 1 Septic tank 4 Lateral lines 7 Pit privy 10 Livestock pens 13 Insecticide Storage 16 Other (specify) 2 Sewer lines 5 Cess pool 8 Sewage lagoon <u>11 Fuel storage</u> 14 Abandoned water well below) 3 Watertight sewer lines 6 Seepage pit 9 Feedyard 12 Fertilizer Storage 15 Oil well/gas well Direction from well? _____ How many feet? <u>IMMEDIATE VICINITY</u>	
<table border="1" style="width:100%; border-collapse: collapse;"> <thead> <tr> <th>FROM</th> <th>TO</th> <th>LITHOLOGIC LOG</th> <th>FROM</th> <th>TO</th> <th>PLUGGING INTERVALS</th> </tr> </thead> <tbody> <tr> <td>0"</td> <td>1'</td> <td>Cement</td> <td></td> <td></td> <td></td> </tr> <tr> <td>1'</td> <td>10"</td> <td>CHOCOLATE MEDIUM PLASTIC, STIFF</td> <td></td> <td></td> <td></td> </tr> <tr> <td>10'</td> <td>15'</td> <td>CLAY: BROWN, SANDY DAMP TR PLASTIC SOFT</td> <td></td> <td></td> <td></td> </tr> <tr> <td>15'</td> <td>31'</td> <td>CH BROWN MOIST HIGH PLASTIC SOFT</td> <td></td> <td></td> <td></td> </tr> <tr> <td>31'</td> <td>50'</td> <td>CL BROWN TR SANDY TR PLASTIC MEDIUM STIFF</td> <td></td> <td></td> <td>Express Cleaners - OB-5</td> </tr> <tr><td> </td><td> </td><td> </td><td> </td><td> </td><td> </td></tr> <tr><td> </td><td> </td><td> </td><td> </td><td> </td><td> </td></tr> <tr><td> </td><td> </td><td> </td><td> </td><td> </td><td> </td></tr> <tr><td> </td><td> </td><td> </td><td> </td><td> </td><td> </td></tr> <tr><td> </td><td> </td><td> </td><td> </td><td> </td><td> </td></tr>
7 CONTRACTOR'S OR LANDOWNER'S CERTIFICATION: This water well was <u>(1)</u> constructed, (2) reconstructed, or (3) plugged under my jurisdiction and was completed on (mo/day/year) <u>10/16/07</u> and this record is true to the best of my knowledge and belief. Kansas Water Well Contractor's License No. <u>665</u> This Water Well Record was completed on (mo/day/year) <u>11/19/07</u> under the business name of <u>Pratt Well Service, Inc.</u> by (signature) <u>[Signature]</u> INSTRUCTIONS: Use typewriter or ball point pen. PLEASE PRESS FIRMLY and PRINT clearly. Please fill in blanks, underline or circle the correct answers. Send top three copies to Kansas Department of Health and Environment, Bureau of Water, Geology Section, 1 000 SW Jackson St., Suite 420, Topeka, Kansas 66612- 1 367. Telephone 785-296-5522. Send one to WATER WELL OWNER and retain one for your records. Fee of \$5.00 for each constructed well. Visit us at http://www.kdhe.state.ks.us/geo/waterwells .	

PROJECT NAME: Salina Regional Medical Center
PROJECT LOCATION: Salina, KS

DRILLING/PROBING CONTRACTOR: Pratt Well Service
DRILLING METHOD / BORE DIAMETER: HSA/8.25
SAMPLING METHOD: 5 foot continuous
TOTAL DEPTH (feet): 50
START DATE: 10/16/07
COMPLETION DATE: 10/16/07

Water Level Data

Date Time Depth

Survey Data

N 38 deg 49.877' W 97 deg 36.534'

PROJECT NUMBER: 17102554
GEOLOGIST: M. Pearce/M. Giuliani
DRILLER: Jon Morgan

SAMPLE DEPTH AND TIME	PID (PPMV)	RECOVERY (FEET)	DEPTH (FEET)	WELL CONSTRUCTION
730	0.8	NA	1	Concept
			2	
			3	
			4	
			5	
740	1.4	NA	6	Hydrated Bentonite
			7	
			8	
			9	
			10	
750	1.1	NA	11	2 In PVC Riser
			12	
			13	
			14	
			15	
755	1.5	NA	16	
			17	
			18	
			19	
			20	
800	1.2	NA	21	
			22	
			23	
			24	
			25	
805				

GEOLOGIC DESCRIPTION (NAME, color, particle size, characteristics)

Asphalt Surface

CH: brn, damp, medium plastic, stiff

CL: brn, damp, TR plastic, medium stiff

CL: brn, sandy, damp, TR plastic, soft

CH: brn, damp, medium plastic, medium stiff

CH: brn, wet, high plastic, soft

CH: brn, moist, plastic, stiff

NOTES:

Note: Well finished with a
Flushmount vault
no odor

no odor

no odor

no odor

no odor

LEGEND:

SS - Split Spoon
PID - Photoionization Detector
NR - No Recovery

- Concrete
- Flush Mount Vault
- Grout

- Bentonite Chip Seal
- Filter Pack
- Well Screen

ST - Shelby Tube
HSA - Hollow Stem Augers
PPMV - Parts Per Million by Volume

PROJECT NAME: Salina Regional Medical Center

GEOLOGIST: M. Pearce/M. Giuliani

PROJECT NUMBER: 17102554

DATE: 10/16/07

SAMPLE DEPTH AND TIME	PID (PPMV)	RECOVERY (FEET)	DEPTH (FEET)	WELL CONSTRUCTION
805	1.2	NA	26	Hydrated Bentonite
			27	
			28	
			29	
			30	
810	0.9	NA	31	2 in PVC Riser
			32	
			33	
			34	
			35	
815	1.1	NA	36	Sand Filter Pack
			37	
			38	
			39	
			40	
825	1.2	NA	41	2 in PVC Screen
			42	
			43	
			44	
			45	
835	1.4	NA	46	
			47	
			48	
			49	
			50	
845				

GEOLOGIC DESCRIPTION
(NAME, color, particle size, characteristics)

NOTES:

CH: brn, moist, plastic, medium stiff

CH: brn, moist, high plastic, soft

CL: brn, TR sandy, TR plastic, medium stiff

Total Depth 50'

LEGEND:

SS - Split Spoon

PID - Photoionization Detector

NR - No Recovery



- Concrete

- Flush Mount Vault

- Grout



- Bentonite Chip Seal

- Filter Pack

- Well Screen

ST - Shelby Tube

HSA - Hollow Stem Augers

PPMV - Parts Per Million by Volume

LEGEND:


- WELL
- R RESIDENCE
- ⊗ ABANDONED

GPS COORDINATES:

OB-1 N:38deg 49.861' W:97deg 36.566'
 OB-3 N:38deg 49.847' W:97deg 36.598'
 OB-4 N:38deg 49.850' W:97deg 36.579'
 OB-5 N:38deg 49.891' W:97deg 36.538'
 DC-2 N:38deg 49.856' W:97deg 36.472'
 DC-2S N:38deg 49.859' W:97deg 36.473'
 EC-OB-5 N:38deg 49.877' W:97deg 36.534'
 PW-7 N:38deg 49.920' W:97deg 36.541'
 MW-10N N:38deg 49.993' W:97deg 36.471'
 MW-10S N:38deg 49.990' W:97deg 36.472'
 MW-10R N:38deg 49.993' W:97deg 36.477'
 MW-11 N:38deg 49.947' W:97deg 36.477'
 MW-12 N:38deg 50.016' W:97deg 36.471'
 MW-13 N:38deg 50.040' W:97deg 36.472'
 MW-14 N:38deg 50.037' W:97deg 36.421'
 MW-15 N:38deg 49.974' W:97deg 36.414'
 MW-19 N:38deg 49.964' W:97deg 36.541'
 MW-20 N:38deg 49.898' W:97deg 36.512'
 MW-21 N:38deg 49.896' W:97deg 36.491'
 MW-22 N:38deg 49.888' W:97deg 36.411'

GPS COORDINATES:

SVE-2 N:38deg 49.854' W:97deg 36.542'
 SVE-4 N:38deg 49.856' W:97deg 36.574'
 SVE-5 N:38deg 49.854' W:97deg 36.564'

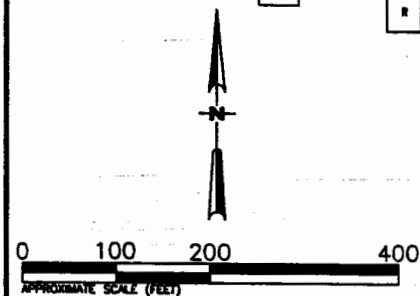


PROJ.# 17102554	PAGE#
SCALE: AS SHOWN	DRAWN BY: CLE
FILE NO. 2554-F1	DESIGNED BY:
DATE: 8-24-07	APPROVED BY:



**FIGURE 1
 SITE PLAN**

**SALINA REGIONAL MEDICAL CENTER
 540 SOUTH SANTA FE
 SALINA, KANSAS**

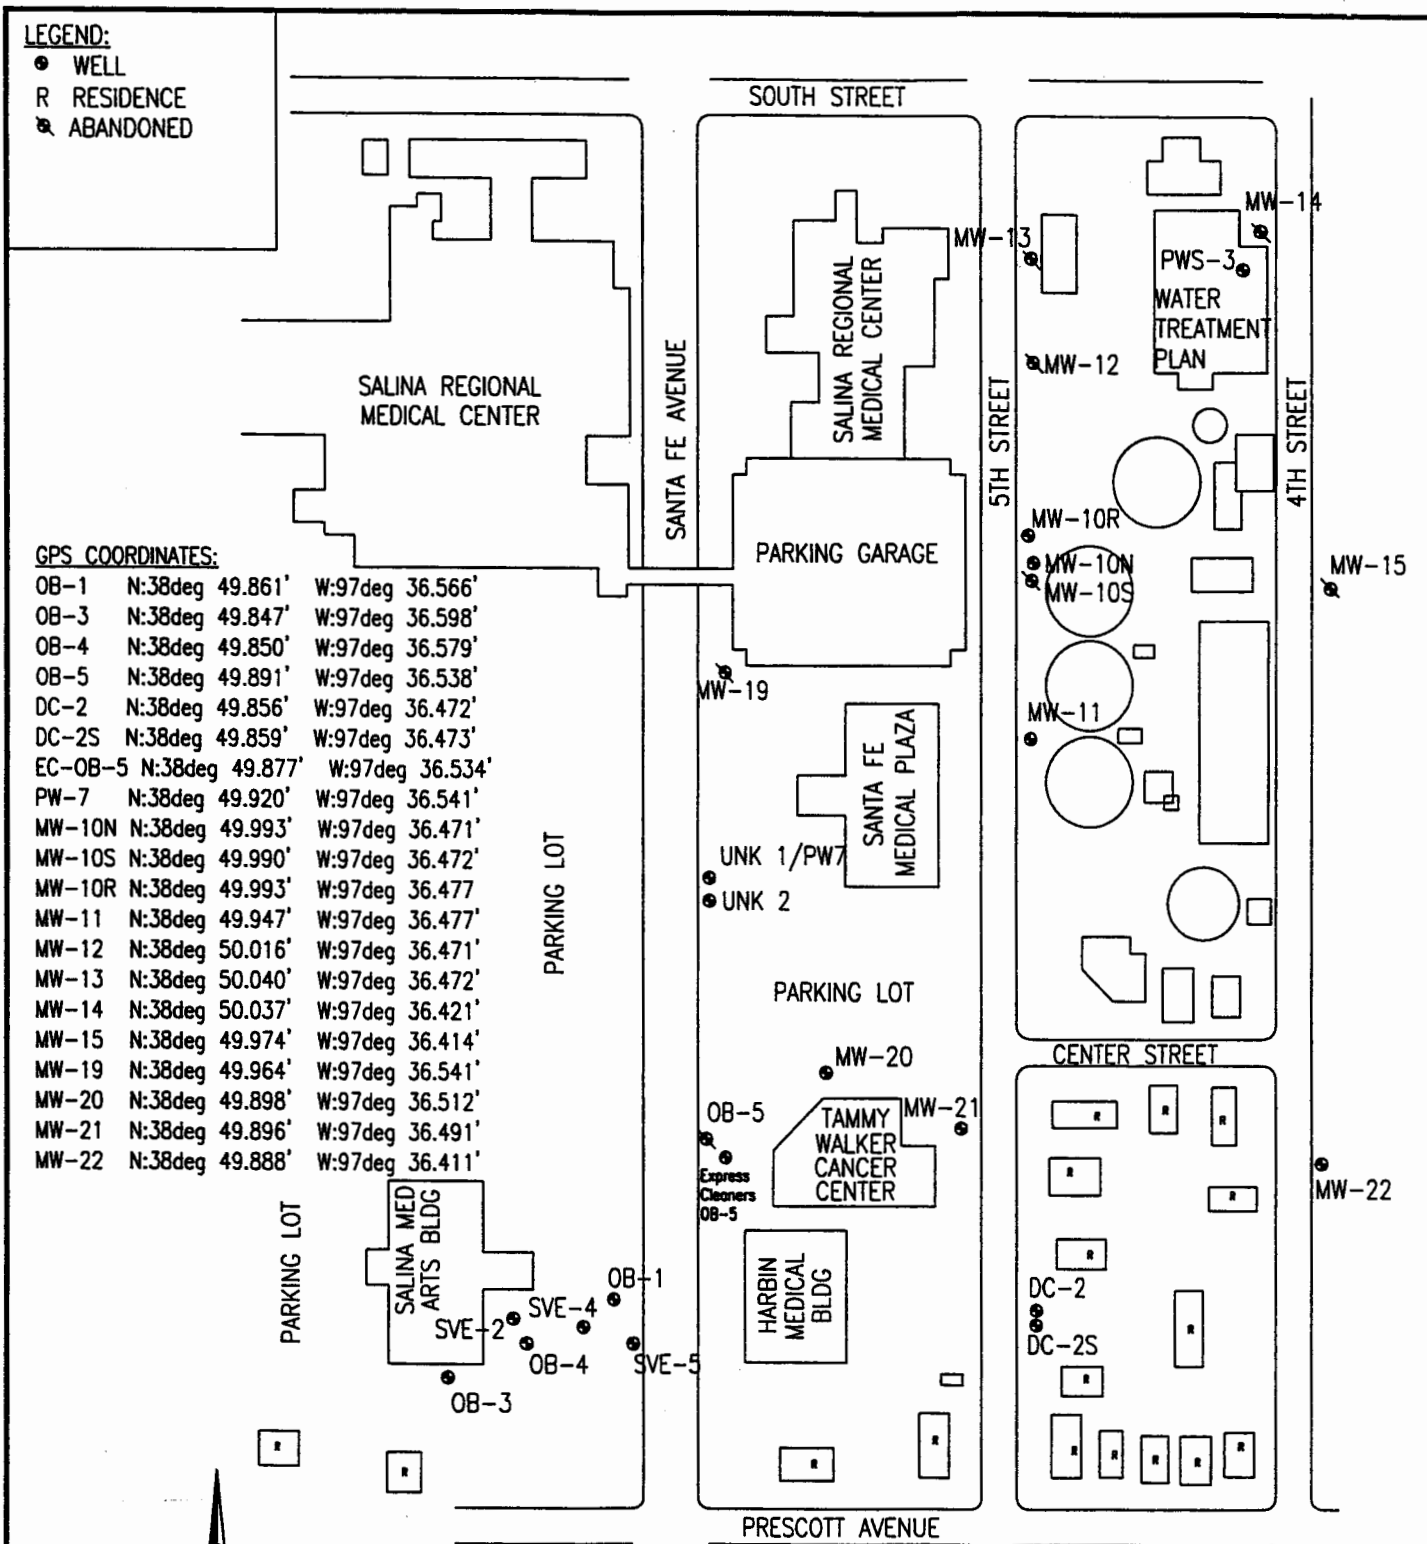

TRITERRA

LAND SERVICES

P.O. Box 546
Clearwater, Kansas 67026
Office (620) 584-2313 Cell (316) 648-3617
Fax (620) 584-4371
E-mail: triterrals@yahoo.com

SURVEYING OF ADDITIONAL MONITORING WELLS SALINA REGIONAL MEDICAL CENTER 540 SOUTH SANTA FE SALINA, KANSAS

The above site is located in Section 13, Township 14 South, Range 3 West of the Sixth Principal Meridian, Saline County, Kansas. The Southeast corner of Section 13 was assigned coordinates of 00.00 North and 00.00 West.

The control point established during a previous survey was used for vertical control. It is described as a chiseled 'X' at the northeast corner of the parking lot for the Salina Medical Arts Building on top of the curb on the inside radius.

The Latitude and Longitude were recorded from a GPS unit. The site is located on the 7.5' topographic quad map titled "Salina".

ID	NORTH	WEST	LATITUDE	LONGITUDE	ELEVATION
SE CORNER 13-14S-3W	00.00	00.00			
CP	1714.63	4428.40	38.83197	97.60953	1229.62
NW SE NW SW CP-5 MW-3R	1534.15	4259.04	38.83145	97.60893	RIM 1229.99 TOC 1229.64
SE SE NW SW					
MW-10R	2173.90	3970.22	38.83319	97.60792	RIM 1226.33 TOC 1226.14
SE NE NW SW					
MW-20	1612.32	4147.95	38.83168	97.60853	RIM 1230.18 TOC 1229.78
SE SE NW SW					
MW-21	1591.47	4054.35	38.83160	97.60820	RIM 1228.87 TOC 1228.40
SE SE NW SW					
MW-22	1500.57	3650.41	38.83135	97.60685	RIM 1228.16 TOC 1227.93
SW SW NE SW					



State of Kansas KDHE/BER Well Tag Form

KDHE Project Code:

4	5	-	0	8	5	-	0	0	8	7	7
---	---	---	---	---	---	---	---	---	---	---	---

Well Tag Number	Well Number
00367444	Express (Leaky) MW-3R OB-5
0041687	MW-10R
0041686	MW-20
0041696	MW-21
0041688	MW-22

After completing this form, photocopy it and keep the copy for your files. Send the original to the address below.

Kansas Department of Health & Environment
Bureau of Environmental Remediation
1000 SW Jackson, Suite 410
Topeka, KS 66612-1367