


1 LOCATION OF WATER WELL: Fraction NE 1/4 NE 1/4 NW 1/4 Section Number 3 Township Number T 14 S Range Number R 5 E/W
 County: SALINE

Distance and direction from nearest town or city street address of well if located within city?
1/2 MILE EAST OF BROOKVILLE RD. STIMMEL RD. INTERSECTION

2 WATER WELL OWNER: RICK LANDIS
 RR#, St. Address, Box #: 781 N. HALSTEAD RD. Board of Agriculture, Division of Water Resources
 City, State, ZIP Code: SALINA, KS. 67401 Application Number:

3 LOCATE WELL'S LOCATION WITH AN "X" IN SECTION BOX:

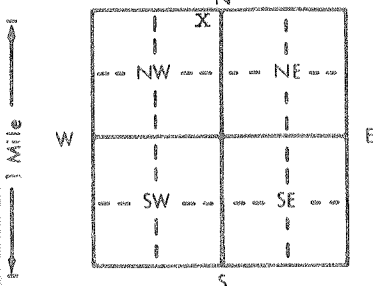

4 DEPTH OF COMPLETED WELL: 118 ft. ELEVATION:
 Depth(s) Groundwater Encountered 1. 68 ft. 2. 68 ft. 3. 68 ft.
 WELL'S STATIC WATER LEVEL: 68 ft. below land surface measured on 7-18-94
 Pump test data: Well water was 80 ? ft. after 2 hours pumping 15 gpm
 Est. Yield 80 ? gpm Well water was 80 ? ft. after 2 hours pumping 15 gpm
 Bore Hole Diameter 9 in. to 118 ft., and 9 in. to 118 ft.
 WELL WATER TO BE USED AS:
 1 Domestic 1 3 Feedlot 6 Oil field water supply 8 Air conditioning 11 Injection well
 2 Irrigation 4 Industrial 7 Lawn and garden only 9 Dewatering 12 Other (Specify below)
 Was a chemical/bacteriological sample submitted to Department? Yes X No X; If yes, mo/day/yr sample was submitted
 Water Well Disinfected? Yes X No

5 TYPE OF BLANK CASING USED:
 1 Steel 3 RMP (SR) 5 Wrought iron 8 Concrete tile CASING JOINTS: Glued X Clamped
 2 PVC 4 ABS 6 Asbestos-Cement 9 Other (specify below) Welded
 7 Fiberglass Threaded
 Blank casing diameter 5 in. to 98 ft., Dia 5 in. to 98 ft., Dia 5 in. to 98 ft.
 Casing height above land surface 20 in., weight 160 lbs./ft. Wall thickness or gauge No. SDR 26

TYPE OF SCREEN OR PERFORATION MATERIAL:
 1 Steel 3 Stainless steel 5 Fiberglass 8 RMP (SR) 10 Asbestos-cement
 2 Brass 4 Galvanized steel 6 Concrete tile 9 ABS 11 Other (specify)
 12 None used (open hole)

SCREEN OR PERFORATION OPENINGS ARE:
 1 Continuous slot 3 Mill slot .035 5 Gauzed wrapped 8 Saw cut 11 None (open hole)
 2 Louvered shutter 4 Key punched 7 Torch cut 9 Drilled holes 10 Other (specify)

SCREEN-PERFORATED INTERVALS: From 98 ft. to 118 ft., From 98 ft. to 118 ft., From 98 ft. to 118 ft.
 GRAVEL PACK INTERVALS: From 60 ft. to 118 ft., From 60 ft. to 118 ft., From 60 ft. to 118 ft.

6 GROUT MATERIAL: 1 Neat cement 2 Cement grout 3 Bentonite 4 Other
 Grout Intervals: From 0 ft. to 26 ft., From 0 ft. to 26 ft., From 0 ft. to 26 ft.

What is the nearest source of possible contamination:
 1 Septic tank 4 Lateral lines 7 Pit privy 10 Livestock pens 14 Abandoned water well
 2 Sewer lines 5 Cess pool 8 Sewage lagoon 11 Fuel storage 15 Oil well/Gas well
 3 Watertight sewer lines 6 Seepage pit 9 Feedyard 12 Fertilizer storage 16 Other (specify below)
 13 Insecticide storage OPEN FIELD NONE APPARENT

Direction from well? How many feet?

FROM	TO	LITHOLOGIC LOG	FROM	TO	PLUGGING INTERVALS
0	2	TOP SOIL			
2	5	SANDSTONE PEBBLES BROWN			
5	12	SANDSTONE TAN SOFT			
12	16	CLAY YELLOW			
16	24	SANDSTONE TAN SOFT			
24	26	CLAY YELLOW			
26	29	CLAY GRAY SOFT			
29	32	CLAY YELLOW			
32	40	CLAY LIGHT GRAY			
40	41	SANDSTONE BROWN HARD			
41	53	CLAY TAN SOFT			
53	83	CLAY GRAY MED. HARD			
83	93	CLAY GRAY MIXED WITH SANDSTONE LAYERS			
93	115	SANDSTONE LIGHT GRAY HARD			
115	118	SHALE DARK GRAY HARD			

7 CONTRACTOR'S OR LANDOWNER'S CERTIFICATION: This water well was (1) constructed, (2) reconstructed, or (3) plugged under my jurisdiction and was completed on (mo/day/year) 7-18-94 and this record is true to the best of my knowledge and belief. Kansas Water Well Contractor's License No. 388 This Water Well Record was completed on (mo/day/yr) 7-18-94 under the business name of PESTINGER PUMP SERVICE by (signature) Paul Pestinger

INSTRUCTIONS: Use typewriter or ball point pen. PLEASE PRESS FIRMLY and PRINT clearly. Please fill in blanks, underline or circle the correct answers. Send top three copies to Kansas Department of Health and Environment, Bureau of Water, Topeka, Kansas 66620-0001. Telephone: 913-296-5545. Send one to WATER WELL OWNER and retain one for your records.