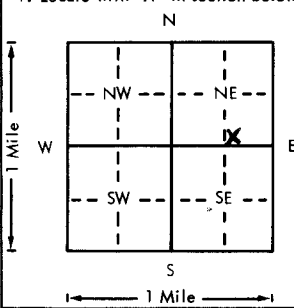


USE TYPEWRITER OR BALL  
POINT PEN-PRESS FIRMLY,  
PRINT CLEARLY.

WATER WELL RECORD  
KSA 82a-1201-1215

Kansas Department of Health and  
Environment-Division of Environment  
(Water well Contractors)  
Topeka, Kansas 66620

1. Location of well:	County <b>Ellsworth</b>	Fraction <b>SW 1/4 SE 1/4 NE 1/4</b>	Section number <b>3</b>	Township number <b>T 14</b>	Range number <b>S R 6 W</b>	E/W
2. Distance and direction from nearest town or city: <b>9 miles NW of Brockville</b>			3. Owner of well: <b>Dan Yordy</b> R.R. or street: <b>670 S. 10th</b> City, state, zip code: <b>Salina KS 67401</b>			
4. Locate with "X" in section below:			Sketch map:			
						
5. Type and color of material			From	To	6. Bore hole dia. <b>6</b> in. Completion date <b>3-29-77</b> Well depth <b>65</b> ft.	
<b>Loess:</b>					7. <input type="checkbox"/> Cable tool <input checked="" type="checkbox"/> Rotary <input type="checkbox"/> Driven <input type="checkbox"/> Dug <input type="checkbox"/> Hollow rod <input type="checkbox"/> Jetted <input type="checkbox"/> Bored <input type="checkbox"/> Reverse rotary	
<b>Clay + silt, brown</b>			<b>0</b>	<b>17</b>	8. Use: <input checked="" type="checkbox"/> Domestic <input type="checkbox"/> Public supply <input type="checkbox"/> Industry <input type="checkbox"/> Irrigation <input type="checkbox"/> Air conditioning <input checked="" type="checkbox"/> Stock <input type="checkbox"/> Lawn <input type="checkbox"/> Oil field water <input type="checkbox"/> Other	
<b>Known:</b>					9. Casing: Material <input type="checkbox"/> Height: <b>above</b> or below Threaded <input type="checkbox"/> Welded <input type="checkbox"/> Surface <b>12</b> in. RMP <input type="checkbox"/> PVC <input checked="" type="checkbox"/> Weight <input type="checkbox"/> lbs./ft. Dia. <b>4</b> in. to <b>65</b> ft. depth Wall Thickness: inches or Dia. <input type="checkbox"/> in. to <input type="checkbox"/> ft. depth gage No. <b>5, 40</b>	
					10. Screen: Manufacturer's name <b>Shop</b> Type <b>slots</b> Dia. <b>4"</b> Slot/gauze <b>3/32"</b> Length <b>5'</b> Set between <b>60</b> ft. and <b>65</b> ft. <input type="checkbox"/> ft. and <input type="checkbox"/> ft. Gravel pack? <input checked="" type="checkbox"/> Size range of material <b>3/8"</b>	
			<b>17</b>	<b>19</b>	11. Static water level: <input type="checkbox"/> mo./day/yr. <b>42</b> ft. below land surface Date <b>3-29-77</b>	
			<b>19</b>	<b>65</b>	12. Pumping level below land surfaces: <b>55</b> ft. after <b>1/2</b> hrs. pumping <b>8</b> g.p.m. <input type="checkbox"/> ft. after <input type="checkbox"/> hrs. pumping <input type="checkbox"/> g.p.m. Estimated maximum yield <b>10</b> g.p.m.	
					13. Water sample submitted: <input type="checkbox"/> Yes <input checked="" type="checkbox"/> No Date <input type="checkbox"/> mo./day/yr.	
					14. Well head completion: <input type="checkbox"/> Pitless adapter <b>12</b> Inches above grade	
					15. Well grouted? <input checked="" type="checkbox"/> With: <input checked="" type="checkbox"/> Neat cement <input type="checkbox"/> Bentonite <input type="checkbox"/> Concrete Depth: From <b>0</b> ft. to <b>10</b> ft.	
					16. Nearest source of possible contamination: ft. <b>0</b> Direction <b>ground</b> Type <b>pasture</b> Well disinfected upon completion? <input checked="" type="checkbox"/> Yes <input type="checkbox"/> No	
					17. Pump: <input checked="" type="checkbox"/> Not installed Manufacturer's name <input type="checkbox"/> Model number <input type="checkbox"/> HP <input type="checkbox"/> Volts <input type="checkbox"/> Length of drop pipe <input type="checkbox"/> ft. capacity <input type="checkbox"/> g.p.m. Type: <input type="checkbox"/> Submersible <input type="checkbox"/> Turbine <input type="checkbox"/> Jet <input type="checkbox"/> Reciprocating <input type="checkbox"/> Centrifugal <input type="checkbox"/> Other	
(Use a second sheet if needed)						
18. Elevation:	19. Remarks:		20. Water well contractor's certification: This well was drilled under my jurisdiction and this report is true to the best of my knowledge and belief. <b>Hydraulic Drilling</b> <b>126</b> Business name <b>Salina Hydr.</b> License No. Address <b>Q. J. Fent</b> <b>8-11-77</b> Signed <b>Q. J. Fent</b> Date <b>8-11-77</b> Authorized representative			

Forward the white, blue and pink copies to the Department of Health and Environment

Form WWC-5