

1 LOCATION OF WATER WELL:	Fraction	Section Number	Township Number	Range Number
County: Ellsworth	NW ¼ NW ¼ SW ¼	16	T 14 S	R 7W E/W

5 E. 6 N of Ellsworth, Kansas


2 WATER WELL OWNER: David Nessler

RR#, St. Address, Box # : Box 18
City, State, ZIP Code : Lorraine, Kansas 67459


3 LOCATE WELL'S LOCATION WITH 4 DEPTH OF COMPLETED WELL 150 ft. ELEVATION: Unknown

AN "X" IN SECTION BOX: Depth(s) Groundwater Encountered 1.100 ft. 2. ft. 3. ft.

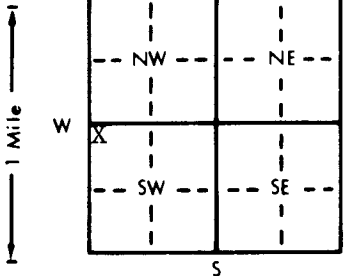

Depth(s) Groundwater Encountered 1.100 ft. 2. ft. 3. ft.

WELL'S STATIC WATER LEVEL 100ft. below land surface measured on mo/day/yr 8/14/92

Est. Yield	20	gpm:	Well water was		ft. after		hours pumping		gpm
------------	----	------	----------------	--	-----------	--	---------------	--	-----

Bore Hole Diameter . . . 8 . . . in. to 150 . . . ft., and . . . in. to . . . ft.

WELL WATER TO BE USED AS:		5 Public water supply	8 Air conditioning	11 Injection well
1 Domestic	3 Feedlot	6 Oil field water supply	9 Dewatering	12 Other (Specify below)

1 Domestic	3 Feedlot	6 Oil field water supply	9 Dewatering	12 Other (Specify below)
2 Irrigation	4 Industrial	7 Lawn and garden only	10 Monitoring well	

Was a chemical/bacteriological sample submitted to Department? Yes.....No.....; If yes, mo/day/yr sample was sub-

mitted		Water Well Disinfected? Yes		No
5. Wrought iron	8. Concrete tile	CASING JOINTS: Glued		Clamped

5 TYPE OF BLANK CASING USED:		5 Wrought iron	6 Concrete tile	CASING JOINTS: <u>Glued</u> Clamped
1 Steel	3 RMP (SR)	6 Asbestos-Cement	9 Other (specify below)	Welded

2 PVC 4 ABS 7 Fiberglass Threaded.....

Blank casing diameter 5 in. to 130 ft., Dia in. to ft., Dia in. to ft.
Casing height above land surface 12 in. weight 2.8 lbs./ft. Wall thickness or gauge No. Sch. 40

TYPE OF SCREEN OR PERFORATION MATERIAL: 7 PVC 10 Asbestos-cement

1 Steel 3 Stainless steel 5 Fiberglass 8 RMP (SR) 11 Other (specify)

2 Brass 4 Galvanized steel 6 Concrete tile 9 ABS 12 None used (open hole)

SCREEN OR PERFORATION OPENINGS ARE: 5 Gauzed/wrapped 8 Saw cut 11 None (open hole)

SCREEN OR PERFORATION OPENINGS ARE:

1 Continuous slot	3 Mill slot	5 Gauzed wrapped	8 Saw cut	11 None (open hole)
		6 Wire wrapped	9 Drilled holes	

2 Louvered shutter 4 Key punched 7 Torch cut 10 Other (specify)

SCREEN-PERFORATED INTERVALS: From 130 ft. to 150 ft., From ft. to ft.
From ft. to ft. From ft. to ft.

GRAVEL PACK INTERVALS: From 20 ft. to 150 ft. From ft. to ft.

From _____ ft. to _____ ft., From _____ ft. to _____ ft.

6 GROUT MATERIAL: 1 Neat cement 2 Cement grout 3 Bentonite 4 Other

Grout Interval: From 0' to 20' # From # to # From # to #

What is the nearest source of possible contamination: 10 Livestock pens 14 Abandoned water well

1 Septic tank	4 Lateral lines	7 Pit privy	11 Fuel storage	15 Oil well/Gas well
---------------	-----------------	-------------	-----------------	----------------------

2 Sewer lines	5 Cess pool	8 Sewage lagoon	12 Fertilizer storage	16 Other (specify below)
3 Watertight sewer lines	6 Scesspool pit	9 Foodyard	13 Insecticide storage	

Direction from well? East How many feet? 300

FROM	TO	LITHOLOGIC LOG	FROM	TO	PLUGGING INTERVALS

0	20	ANRR	Clay			
20	110		Shale			

110	150	Sand rock with shale streaks
-----	-----	------------------------------

[illegible]

1

[illegible][illegible]

[illegible][illegible][illegible][illegible]

7 CONTRACTOR'S OR LANDOWNER'S CERTIFICATION: This water well was (1) constructed, (2) reconstructed, or (3) plugged under my jurisdiction and was

completed on (mo/day/year) 8/14/92 and this record is true to the best of my knowledge and belief. Kansas
 Water Well Completion No. 186 This Water Well Record was completed on (mo/day/year) 8/31/92

under the business name of Kelly's Water Well Service, Inc. by (signature) [Signature]

INSTRUCTIONS: Use typewriter or ball point pen. PLEASE PRESS FIRMLY and PRINT clearly. Please fill in blanks, underline or circle the correct answers. Send top three copies to Kansas Department

of Health and Environment, Bureau of Water, Topeka, Kansas 66620-0001. Telephone: 913-296-5545. Send one to WATER WELL OWNER and retain one for your records.