


1 LOCATION OF WATER WELL: Fraction SW 1/4 NW 1/4 SW 1/4 Section Number 9 Township Number T 14 S Range Number R 8 E/W

Distance and direction from nearest town or city street address of well if located within city? Jct I-70 & Hwy 14, Ellsworth, Kansas

2 WATER WELL OWNER: Cliff's Service RR#, St. Address, Box #: 275 Highway 14 City, State, ZIP Code: Ellsworth, Kansas 67439-8514 Board of Agriculture, Division of Water Resources Application Number:

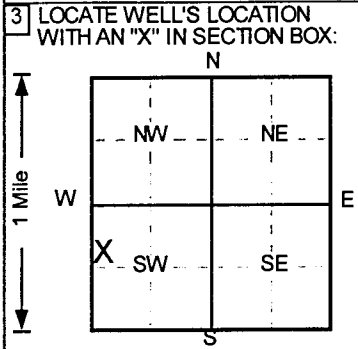

4 DEPTH OF COMPLETED WELL 40 ft ELEVATION: 1781.26 Depth(s) Groundwater Encountered 1. 24.71 ft 2. ft 3. ft WELL'S STATIC WATER LEVEL 27.86 ft below land surface measured on mo/day/yr 11/4/97

5 TYPE OF BLANK CASING USED: 1 Steel 2 PVC 3 RMP (SR) 4 ABS 5 Wrought iron 6 Asbestos-Cement 7 Fiberglass 8 Concrete tile 9 Other (specify below) CASING JOINTS: Glued Clamped Welded Threaded

6 GROUT MATERIAL: 1 Neat cement 2 Cement grout 3 Bentonite 4 Other Grout Intervals: From 0 ft to 21 ft, From 21 ft to 23 ft

LITHOLOGIC LOG table with columns FROM, TO, LITHOLOGIC LOG, FROM, TO, PLUGGING INTERVALS. Rows include Gravel (0-2), Clay, Dark Brown (2-10), Clay, Light Brown (10-22), Shale, Yellow (22-34), and Shale, Gray (34-40).

7 CONTRACTOR'S OR LANDOWNER'S CERTIFICATION: This water well was (1) constructed, (2) reconstructed, or (3) plugged under my jurisdiction and was completed on (mo/day/year) 8/14/97

INSTRUCTIONS: Use typewriter or ball point pen. PLEASE PRESS FIRMLY and PRINT clearly. Please fill in blanks, underline or circle the correct answers.