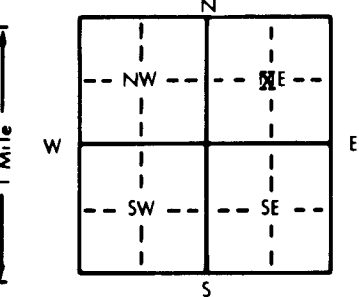


1 LOCATION OF WATER WELL: Fraction C 1/4 NE 1/4 1/4 Section Number 19 Township Number T 14 S Range Number R 8W E/W  
 County: Ellsworth

Distance and direction from nearest town or city street address of well if located within city?  
 1 W, 6 N of Ellsworth, Kansas

2 WATER WELL OWNER: Don Kihn  
 RR#, St. Address, Box #: Ellsworth, Ks. Board of Agriculture, Division of Water Resources  
 City, State, ZIP Code: 67439 Application Number:

3 LOCATE WELL'S LOCATION WITH AN "X" IN SECTION BOX:  


4 DEPTH OF COMPLETED WELL: 205 ft. ELEVATION: Unknown  
 Depth(s) Groundwater Encountered: 1. 160 ft. 2. . ft. 3. . ft.  
 WELL'S STATIC WATER LEVEL: 160 ft. below land surface measured on mo/day/yr 7/23/91  
 Pump test data: Well water was . ft. after . hours pumping . gpm  
 Est. Yield: 20 gpm: Well water was . ft. after . hours pumping . gpm  
 Bore Hole Diameter: 8 in. to 205 ft., and . in. to . ft.  
 WELL WATER TO BE USED AS:  
 1 Domestic 3 Feedlot 6 Oil field water supply 9 Dewatering 12 Other (Specify below)  
 2 Irrigation 4 Industrial 7 Lawn and garden only 10 Monitoring well  
 Was a chemical/bacteriological sample submitted to Department? Yes . No .; If yes, mo/day/yr sample was submitted .  
 Water Well Disinfected? Yes . No .

5 TYPE OF CASING USED:  
 1 Steel 3 RMP (SR) 5 Wrought iron 8 Concrete tile CASING JOINTS: Glued . Clamped .  
 2 PVC 4 ABS 6 Asbestos-Cement 9 Other (specify below) Welded .  
 7 Fiberglass Threaded .  
 Blank casing diameter: 5 in. to 185 ft., Dia . in. to . ft., Dia . in. to . ft.  
 Casing height above land surface: 12 in, weight: 2.8 lbs./ft. Wall thickness or gauge No. Sch. 40  
 TYPE OF SCREEN OR PERFORATION MATERIAL:  
 1 Steel 3 Stainless steel 5 Fiberglass 8 RMP (SR) 10 Asbestos-cement  
 2 Brass 4 Galvanized steel 6 Concrete tile 9 ABS 12 None used (open hole)  
 SCREEN OR PERFORATION OPENINGS ARE:  
 1 Continuous slot 3 Mill slot 5 Gauzed wrapped 8 Saw cut 11 None (open hole)  
 2 Louvered shutter 4 Key punched 6 Wire wrapped 9 Drilled holes  
 7 Torch cut 10 Other (specify) .  
 SCREEN-PERFORATED INTERVALS: From 185 ft. to 205 ft., From . ft. to . ft.  
 From . ft. to . ft., From . ft. to . ft.  
 GRAVEL PACK INTERVALS: From 20 ft. to 205 ft., From . ft. to . ft.  
 From . ft. to . ft., From . ft. to . ft.

6 GROUT MATERIAL: 1 Neat cement 2 Cement grout 3 Bentonite 4 Other .  
 Grout intervals: From 0 ft. to 20 ft., From . ft. to . ft., From . ft. to . ft.  
 What is the nearest source of possible contamination:  
 1 Septic tank 4 Lateral lines 7 Pit privy 10 Livestock pens 14 Abandoned water well  
 2 Sewer lines 5 Cess pool 8 Sewage lagoon 11 Fuel storage 15 Oil well/Gas well  
 3 Watertight sewer lines 6 Seepage pit 9 Feedyard 12 Fertilizer storage 16 Other (specify below)  
 13 Insecticide storage . In pasture .  
 Direction from well? How many feet?

FROM	TO	LITHOLOGIC LOG	FROM	TO	PLUGGING INTERVALS
0	20	Clay			
20	160	Shale			
160	205	Sand rock			

7 CONTRACTOR'S OR LANDOWNER'S CERTIFICATION: This water well was (1) constructed, (2) reconstructed, or (3) plugged under my jurisdiction and was completed on (mo/day/year) 7/23/91 and this record is true to the best of my knowledge and belief. Kansas Water Well Contractor's License No. 186 This Water Well Record was completed on (mo/day/yr) 8/15/91 under the business name of Kelly's Water Well Service by (signature) *Severy*

OFFICE USE ONLY

T

R

EW

SEC.

1/4

1/4

1/4