


1	LOCATION OF WATER WELL: County: Ellsworth	Fraction NW ¼ SE ¼ SW ¼	Section Number 21	Township Number 14	Range Number 8 W
---	--	----------------------------	----------------------	-----------------------	---------------------

Distance and direction from nearest town or city street address of well if located within city? N/A

2 WATER WELL OWNER: John H. Tanton Jr.  
 RR #, St. Address, Box #: 1525 Avenue E Board of Agriculture, Division of Water Resources  
 City, State, ZIP Code : Ellsworth, KS 67439 Application Number:

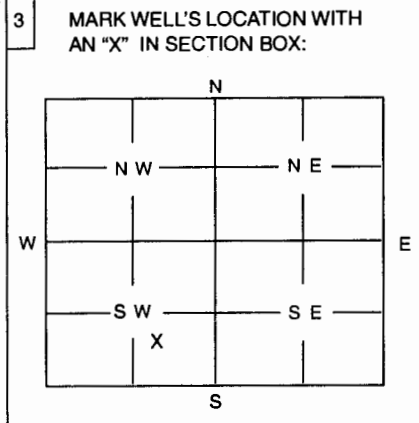

4 DEPTH OF WELL ..... 46 ..... ft  
 WELL'S STATIC WATER LEVEL ..... 38 ..... ft.  
 WELL WAS USED AS:  
 1 Domestic      5 Public Water Supply      9 Dewatering  
 2 Irrigation      6 Oil Field Water Supply      10 Monitoring Well  
 3 Feedlot      7 Domestic (Lawn & Garden)      11 Injection Well  
 4 Industrial      8 Air Conditioning      12 Other .....  
 Was a chemical / bacteriological sample submitted to Department? Yes ..... No ...X.....  
 If yes, mo/day/yr sample was submitted .....  
 Water Well Disinfected: Yes ...X.... No .....

5 TYPE OF BLANK CASING USED:  
 1 Steel      3 RMP (SR)      5 Wrought      7 Fiberglass      9 Other (Specify below) Sandstone Rock  
 2 PVC      4 ABS      6 Asbestos-Cement      8 Concrete Tile  
 Blank casing diameter ..... 36 ..... in. Was casing pulled? Yes ..... No ...X..... If yes, how much .....  
 Casing height above or below land surface ..... 60 ..... in. below

6 GROUT PLUG MATERIAL: 1 Neat cement      2 Cement grout      3 Bentonite      4 Other .....  
 Grout Plug Intervals: From ..... 5 ..... ft. to ..... 4.5 ..... ft., From ..... ft. to ..... ft., From ..... to ..... ft.  
 What is the nearest source of possible contamination:  
 1 Septic tank      6 Seepage pit      11 Fuel storage      16 Other (specify below) Fertilizers & Pesticides  
 2 Sewer lines      7 Pit privy      12 Fertilizer storage  
 3 Watertight sewer lines      8 Sewage lagoon      13 Insecticide storage  
 4 Lateral lines      9 Feedyard      14 Abandoned water well  
 5 Cess Pool      10 Livestock pens      15 Oil well/Gas well  
 Direction from well? ..... North ..... How many feet? ..... 150 .....

FROM	TO	PLUGGING MATERIALS
46	38	Chlorinated Sand
38	18	Subsoil Clays
18	5	Fill Sand
5	4.5	Bentonite
4.5	0	Topsoil

7 CONTRACTOR'S OR LANDOWNER'S CERTIFICATION: This water well was plugged under my jurisdiction and was completed on (mo/day/year) 9-24-01 and this record is true to the best of my knowledge and belief. Kansas Water Well Contractor's License No. 10-17-01 under the business name of Landowner This Water Well Record was completed on (mo/day/year) by (signature) John Tanton by Nancy Tanton

INSTRUCTIONS: Use typewriter or ball point pen. Please press firmly and print clearly. Please fill in blanks, underline or circle the correct answers. Send top three copies to Kansas Department of Health and Environment, Bureau of Water, Topeka, Kansas 66620-0001. Telephone: 785/296-3565. Send one to Water Well Owner and retain one for your records.