


1	LOCATION OF WATER WELL:	Fraction	Section Number	Township Number	Range Number
	County: Ellsworth	NW ¼ NW ¼ NE ¼	2	14	8

Distance and direction from nearest town or city street address of well if located within city?
N/A

2 WATER WELL OWNER: Wayne Bohl
 RR #, St. Address, Box #: 1625 Avenue B
 City, State, ZIP Code : Ellsworth, KS 67439
 Board of Agriculture, Division of Water Resources
 Application Number:

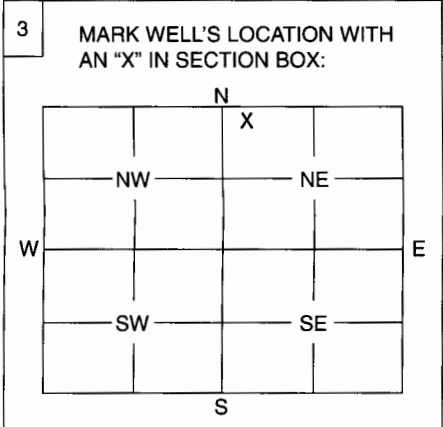

4 DEPTH OF WELL 79 ft.
 WELL'S STATIC WATER LEVEL 71 ft.

WELL WAS USED AS:

<input checked="" type="checkbox"/> 1 Domestic	5 Public Water Supply	9 Dewatering
<input type="checkbox"/> 2 Irrigation	6 Oil Field Water Supply	10 Monitoring Well
<input type="checkbox"/> 3 Feedlot	7 Domestic (Lawn & Garden)	11 Injection Well
<input type="checkbox"/> 4 Industrial	8 Air Conditioning	12 Other

Was a chemical / bacteriological sample submitted to Department? Yes No
 If yes, mo/day/yr sample was submitted

Water Well Disinfected: Yes No

5 TYPE OF BLANK CASING USED:

1 Steel	3 RMP (SR)	5 Wrought	7 Fiberglass	<input checked="" type="checkbox"/> 9 Other (Specify below)
2 PVC	4 ABS	6 Asbestos-Cement	8 Concrete Tile	Galvanized Metal

Blank casing diameter 6 in. Was casing pulled? Yes No If yes, how much

Casing height above or below land surface 36 in. below

6 GROUT PLUG MATERIAL: 1 Neat cement 2 Cement grout 3 Bentonite 4 Other

Grout Plug Intervals: From 67 ft. to 64 ft., From 6 ft. to 3 ft., From to ft.

What is the nearest source of possible contamination:

1 Septic tank	6 Seepage pit	11 Fuel storage	16 Other (specify below)
2 Sewer lines	7 Pit privy	12 Fertilizer storage
3 Watertight sewer lines	8 Sewage lagoon	13 Insecticide storage
4 Lateral lines	9 Feedyard	<input checked="" type="checkbox"/> 14 Abandoned water well
5 Cess pool	10 Livestock pens	15 Oil well/Gas well

Direction from well? South How many feet? 900

FROM	TO	PLUGGING MATERIALS
79	67	Chlorinated Sand
67	64	Bentonite
64	6	Fill Sand
6	3	Bentonite
3	0	Topsoil

7 CONTRACTOR'S OF LANDOWNER'S CERTIFICATION: This water well was plugged under my jurisdiction and was completed on (mo/day/year) 7-20-2005 and this record is true to the best of my knowledge and belief. Kansas Water Well Contractor's License No. This Water Well Record was completed on (mo/day/year) 7-22-2005 under the business name of Ellsworth County NPS Coordinator by (signature) *Brad Rutz*

INSTRUCTIONS: Use typewriter or ball point pen. Please press firmly and print clearly. Please fill in blanks, underline or circle the correct answers. Send top three copies to Kansas Department of Health and Environment, Bureau of Water, Geology Section, 1000 SW Jackson St., Ste. 420, Topeka, Kansas 66612-1367. Telephone: 785/296-5522. Send one to Water Well Owner and retain one for your records.