WATER WELL PLUGGING RECORD Form WWC-5P KSA 82a-1212 ID NO._____

1 LOCATION OF WATER WELL:	Fraction	Section Number	Township Number	Range Number
County: Ellsworth	NE¼ SW ¼ NW ¼	24	14	9 E (W)

Distance and direction from nearest town or city street address of well if located within city?
N/A

2 WATER WELL OWNER: Ruth Warttig
RR #, St. Address, Box #: 4328 S Pratt Avenue
City, State, ZIP Code : Springfield, MO 65804
Board of Agriculture, Division of Water Resources Application Number:

3 MARK WELL'S LOCATION WITH AN "X" IN SECTION BOX:

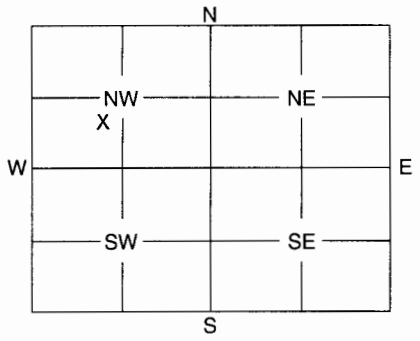

4 DEPTH OF WELL 171 ft.
WELL'S STATIC WATER LEVEL 147 ft.
WELL WAS USED AS:
(1) Domestic 2 Irrigation 3 Feedlot 4 Industrial 5 Public Water Supply 6 Oil Field Water Supply 7 Domestic (Lawn & Garden) 8 Air Conditioning 9 Dewatering 10 Monitoring Well 11 Injection Well 12 Other
Was a chemical / bacteriological sample submitted to Department? Yes ..... No X
If yes, mo/day/yr sample was submitted .....
Water Well Disinfected: Yes X No .....

5 TYPE OF BLANK CASING USED:
1 Steel 2 PVC 3 RMP (SR) 4 ABS 5 Wrought 6 Asbestos-Cement 7 Fiberglass 8 Concrete Tile (9) Other (Specify below) Galvanized Metal
Blank casing diameter 6 in. Was casing pulled? Yes ..... No X If yes, how much .....
Casing height above or below land surface 36 in. below

6 GROUT PLUG MATERIAL: 1 Neat cement 2 Cement grout (3) Bentonite 4 Other .....
Grout Plug Intervals: From 145 ft. to 142 ft., From 7 ft. to 3 ft., From ..... to ..... ft.
What is the nearest source of possible contamination:
1 Septic tank 2 Sewer lines 3 Watertight sewer lines 4 Lateral lines 5 Cess pool 6 Seepage pit 7 Pit privy 8 Sewage lagoon (9) Feedyard (10) Livestock pens 11 Fuel storage 12 Fertilizer storage 13 Insecticide storage 14 Abandoned water well 15 Oil well/Gas well 16 Other (specify below)
Direction from well? All How many feet? Immediate

FROM	TO	PLUGGING MATERIALS
171	145	Chlorinated Sand
145	142	Bentonite
142	100	~~XXXXXX XXXXX~~ Fill Sand
100	7	Subsoil Clays
7	3	Bentonite
3	0	Topsoil

7 CONTRACTOR'S OF LANDOWNER'S CERTIFICATION: This water well was plugged under my jurisdiction and was completed on (mo/day/year) 3-13-2009 and this record is true to the best of my knowledge and belief. Kansas Water Well Contractor's License No. ..... This Water Well Record was completed on (mo/day/year) 4-7-2009 under the business name of Ellsworth County NPS Coordinator by (signature) Ruth Kuntz

INSTRUCTIONS: Use typewriter or ball point pen. Please press firmly and print clearly. Please fill in blanks, underline or circle the correct answers. Send top three copies to Kansas Department of Health and Environment, Bureau of Water, Geology Section, 1000 SW Jackson St., Ste. 420, Topeka, Kansas 66612-1367. Telephone: 785/296-5522. Send one to Water Well Owner and retain one for your records.