


1 LOCATION OF WATER WELL: Fraction 0 55 NE Section Number 1 Township Number T 15 Range Number R 10  
 County: Ellsworth NE 1/4 NE 1/4 NE 1/4 S E

Distance and direction from nearest town or city street address of well if located within city?  
Approx. 6 mi East of Wilson, KS.

2 WATER WELL OWNER: Gordon Blue Board of Agriculture, Division of Water Resources  
 RR#, St. Address, Box #: 820 N. Lincoln Ave. Application Number:  
 City, State, ZIP Code: Ellsworth, Ke. 67439

3 LOCATE WELL'S LOCATION WITH AN "X" IN SECTION BOX:

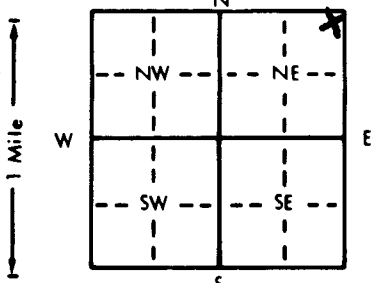

4 DEPTH OF COMPLETED WELL: 55' ft. ELEVATION:  
 Depth(s) Groundwater Encountered: 1 22' ft. 2. ft. 3. ft.  
 WELL'S STATIC WATER LEVEL: ft. below land surface measured on mo/day/yr  
 Pump test data: Well water was ft. after hours pumping 12 gpm  
 Est. Yield 12 gpm: Well water was ft. after hours pumping gpm  
 Bore Hole Diameter: 8 in. to 55' ft., and in. to ft.  
 WELL WATER TO BE USED AS:  
 1 Domestic  3 Feedlot  6 Oil field water supply  9 Dewatering  12 Other (Specify below) LIVESTOCK  
 2 Irrigation  4 Industrial  7 Lawn and garden only  10 Monitoring well  
 Was a chemical/bacteriological sample submitted to Department? Yes No X; If yes, mo/day/yr sample was submitted  
 Water Well Disinfected?  Yes No

5 TYPE OF BLANK CASING USED:  
 1 Steel  3 RMP (SR)  6 Asbestos-Cement  9 Other (specify below) Welded  
 2 PVC  4 ABS  7 Fiberglass Threaded  
 Blank casing diameter: 5" in. to 22' ft. Dia. 5" perforated to 30' ft. Dia. 5" blank to 55' ft.  
 Casing height above land surface: 12 in., weight lbs./ft. Wall thickness or gauge No. SH200

TYPE OF SCREEN OR PERFORATION MATERIAL:  
 1 Steel  3 Stainless steel  5 Fiberglass  8 RMP (SR)  10 Asbestos-cement  
 2 Brass  4 Galvanized steel  6 Concrete tile  9 ABS  11 Other (specify)  
 12 None used (open hole)

SCREEN OR PERFORATION OPENINGS ARE:  
 1 Continuous slot  3 Mill slot  6 Wire wrapped  9 Drilled holes  
 2 Louvered shutter  4 Key punched  7 Torch cut  10 Other (specify) Factory cut

SCREEN-PERFORATED INTERVALS: From 22 ft. to 30 ft., From ft. to ft.  
 From ft. to ft., From ft. to ft.  
 GRAVEL PACK INTERVALS: From 22 ft. to 55 ft., From ft. to ft.  
 From ft. to ft., From ft. to ft.

6 GROUT MATERIAL:  1 Neat cement 22  2 Cement grout  3 Bentonite  4 Other  
 Grout Intervals: From 0 ft. to 22 ft., From ft. to ft., From ft. to ft., From ft. to ft.

What is the nearest source of possible contamination:  
 1 Septic tank  4 Lateral lines  7 Pit privy  10 Livestock pens  14 Abandoned water well  
 2 Sewer lines  5 Cess pool  8 Sewage lagoon  11 Fuel storage  15 Oil well/Gas well  
 3 Watertight sewer lines  6 Seepage pit  9 Feedyard  12 Fertilizer storage  16 Other (specify below) Pond East of Well  
 13 Insecticide storage

Direction from well? How many feet?

FROM	TO	LITHOLOGIC LOG	FROM	TO	PLUGGING INTERVALS
0	3	Topsoil			
3	22	Brown Clay			
22	29	Coarse Sand			
29	55	Red Clay			

7 CONTRACTOR'S OR LANDOWNER'S CERTIFICATION: This water well was  (1) constructed, (2) reconstructed, or (3) plugged under my jurisdiction and was completed on (mo/day/year) 4/14/98 and this record is true to the best of my knowledge and belief. Kansas Water Well Contractor's License No. 619 This Water Well Record was completed on (mo/day/yr) 4/20/98 under the business name of Bushell Waterwell Service by (signature) Rita J. Bushell