

CORRECTION TO WATER WELL RECORD (WWC-5)

The following correction(s) was made to the attached WWC-5 log, in order to file the item or to rectify lacking or incorrect information.

Fraction ( 1/4 1/4 1/4) Section-Township-Range changed:

listed as NE SE, 24-15S-11W

changed to NE NE SE, 24-15S-11W

Other changes: Initial statements: Barton County

Changed to: Russell County

Comments:

verification method: Written & legal descriptions, and Wilson &

Holyrood NW 1:24,000 topo maps.  
(Buildings shown on map)


initials: DR date: 8/2/2000

submitted by: Kansas Geological Survey, Data Resources Library, 1930 Constant Ave., Lawrence, KS 66047-3726  
to: Kansas Dept of Health & Environment Bureau of Water Industrial Programs, Bldg 283, Forbes Field, KS 66620

1 LOCATION OF WATER WELL: Fraction  $\frac{1}{4}$  NE  $\frac{1}{4}$  SE  $\frac{1}{4}$  Section Number 24 Township Number T 15 S Range Number R 11 EW

Distance and direction from nearest town or city street address of well if located within city?  
 From Wilson KS Main & Hwy 40 6 mi South West 1/4

2 WATER WELL OWNER: Harry Swartz  
 RR#, St. Address, Box #: PO Box 191  
 City, State, ZIP Code: Wilson KS 67490  
 Board of Agriculture, Division of Water Resources  
 Application Number:

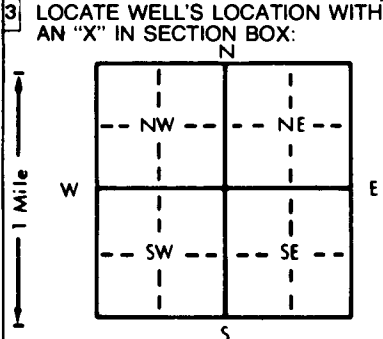

4 DEPTH OF COMPLETED WELL: 340 ft. ELEVATION:  
 Depth(s) Groundwater Encountered 1. 320 ft. 2. ft. 3. ft.  
 WELL'S STATIC WATER LEVEL: 210 ft. below land surface measured on mo/day/yr  
 Pump test data: Well water was 320 ft. after 48 hours pumping 11 gpm  
 Est. Yield 11 gpm Well water was ft. after hours pumping gpm  
 Bore Hole Diameter: 8.74 in. to 3.40 ft., and in. to ft.  
 WELL WATER TO BE USED AS:  
 1 Domestic 3 Feedlot 6 Oil field water supply 9 Dewatering 12 Other (Specify below)  
 2 Irrigation 4 Industrial 7 Lawn and garden only 10 Monitoring well livestock & lawn  
 Was a chemical/bacteriological sample submitted to Department? Yes No X; If yes, mo/day/yr sample was submitted  
 Water Well Disinfected? Yes X No

5 TYPE OF BLANK CASING USED:  
 1 Steel 3 RMP (SR) 5 Wrought iron 8 Concrete tile CASING JOINTS: Glued X Clamped  
 X PVC 4 ABS 6 Asbestos-Cement 9 Other (specify below) Welded  
 7 Fiberglass Threaded  
 Blank casing diameter 5 in. to 300 ft., Dia. in. to ft., Dia. in. to ft.  
 Casing height above land surface 24 in., weight SR 21 lbs./ft. Wall thickness or gauge No. 200psi  
 TYPE OF SCREEN OR PERFORATION MATERIAL:  
 1 Steel 3 Stainless steel 5 Fiberglass 8 RMP (SR) 10 Asbestos-cement  
 2 Brass 4 Galvanized steel 6 Concrete tile 9 ABS 11 Other (specify)  
 12 None used (open hole)  
 SCREEN OR PERFORATION OPENINGS ARE:  
 1 Continuous slot 3 Mill slot 5 Gauzed wrapped X Saw cut 11 None (open hole)  
 2 Louvered shutter 4 Key punched 6 Wire wrapped 9 Drilled holes  
 7 Torch cut 10 Other (specify)  
 SCREEN-PERFORATED INTERVALS: From 210 ft. to 340 ft., From ft. to ft.  
 From ft. to ft., From ft. to ft.  
 GRAVEL PACK INTERVALS: From 150 ft. to 340 ft., From ft. to ft.  
 From ft. to ft., From ft. to ft.

6 GROUT MATERIAL: 1 Neat cement 2 Cement grout X Bentonite 4 Other  
 Grout Intervals: From 150 ft. to 5 ft., From ft. to ft., From ft. to ft.  
 What is the nearest source of possible contamination:  
 1 Septic tank 4 Lateral lines 7 Pit privy 10 Livestock pens 14 Abandoned water well  
 2 Sewer lines 5 Cess pool 8 Sewage lagoon 11 Fuel storage 15 Oil well/Gas well  
 3 Watertight sewer lines 6 Seepage pit 9 Feedyard 12 Fertilizer storage 16 Other (specify below)  
 13 Insecticide storage  
 Direction from well? How many feet?

FROM	TO	LITHOLOGIC LOG	FROM	TO	PLUGGING INTERVALS
0	12	lime stone			
12	50	Black shale w lime layers			
50	150	Hard Black shale			
150	200	Blue shale			
200	215	Black shale w Iron Pyrite			
215	285	Sandy Black shale			
285	295	Iron Pyrite & shale			
295	300	lime & sandy lime			
300	320	Blue shale			
320	330	Sand Rock Bone			
330	335	White Sand			
335	340	Sandy shale			

7 CONTRACTOR'S OR LANDOWNER'S CERTIFICATION: This water well was X constructed, (2) reconstructed, or (3) plugged under my jurisdiction and was completed on (mo/day/year) 6-12-2000 and this record is true to the best of my knowledge and belief. Kansas Water Well Contractor's License No. 660 This Water Well Record was completed on (mo/day/yr) 6-15-00 under the business name of Goodman Water Well Drilling by (signature) Jack Hood

INSTRUCTIONS: Use typewriter or ball point pen. PLEASE PRESS FIRMLY and PRINT clearly. Please fill in blanks, underline or circle the correct answers. Send top three copies to Kansas Department of Health and Environment, Bureau of Water, Topeka, Kansas 66620-0001. Telephone: 913-296-5545. Send one to WATER WELL OWNER and retain one for your records.