

1	LOCATION OF WATER WELL:	Fraction	Section Number	Township Number	Range Number
County:	<u>LYON</u>	<u>SW 1/4 NW 1/4 1/4</u>	<u>36</u>	<u>15</u>	<u>11</u>

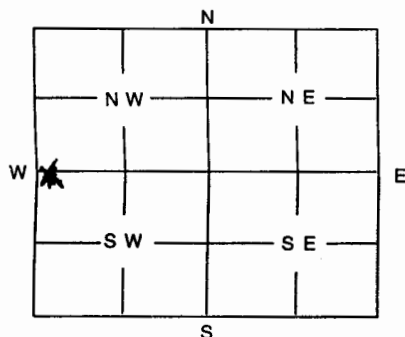
Distance and direction from nearest town or city street address of well if located within city?

N/A

2 WATER WELL OWNER: Bryce Davidson

RR #, St. Address, Box #: 2871 Rd P Board of Agriculture, Division of Water Resources
 City, State, ZIP Code: Admire, KS 66830 Application Number: _____

3 MARK WELL'S LOCATION WITH AN "X" IN SECTION BOX:

4 DEPTH OF WELL 29 ftWELL'S STATIC WATER LEVEL 9 1/2 ft.

WELL WAS USED AS:

- | | | |
|--|----------------------------|--------------------|
| <input checked="" type="checkbox"/> 1 Domestic | 5 Public Water Supply | 9 Dewatering |
| 2 Irrigation | 6 Oil Field Water Supply | 10 Monitoring Well |
| 3 Feedlot | 7 Domestic (Lawn & Garden) | 11 Injection Well |
| 4 Industrial | 8 Air Conditioning | 12 Other |

Was a chemical / bacteriological sample submitted to Department? Yes No X
 If yes, mo/day/yr sample was submitted

Water Well Disinfected: Yes X No

5 TYPE OF BLANK CASING USED:

- | | | | | |
|---------|------------|-------------------|-----------------|-------------------------------------|
| 1 Steel | 3 RMP (SR) | 5 Wrought | 7 Fiberglass | 9 Other (Specify below) <u>Rock</u> |
| 2 PVC | 4 ABS | 6 Asbestos-Cement | 8 Concrete Tile | |

Blank casing diameter 48 in. Was casing pulled? Yes X No If yes, how much 5 ft
 Casing height above or below land surface 60 in.

6 GROUT PLUG MATERIAL: 1 Neat cement 2 Cement grout 3 Bentonite 4 Other
 Grout Plug Intervals: From 5 ft. to 4 1/2 ft., From ft. to ft., From to ft.

What is the nearest source of possible contamination:

- | | | | |
|--------------------------|-------------------|-------------------------|---|
| 1 Septic tank | 6 Seepage pit | 11 Fuel storage | 16 Other (specify below) <u>Crop Land</u> |
| 2 Sewer lines | 7 Pit privy | 12 Fertilizer storage | |
| 3 Watertight sewer lines | 8 Sewage lagoon | 13 Insecticide storage | |
| 4 Lateral lines | 9 Feedyard | 14 Abandoned water well | |
| 5 Cess Pool | 10 Livestock pens | 15 Oil well/Gas well | |

Direction from well? South How many feet? 100

FROM	TO	PLUGGING MATERIALS
<u>29</u>	<u>19 1/2</u>	<u>SAND</u>
<u>19 1/2</u>	<u>5</u>	<u>Subsoil</u>
<u>5</u>	<u>4 1/2</u>	<u>Bentonite</u>
<u>4 1/2</u>	<u>0</u>	<u>Top Soil</u>

RECEIVED
 OCT 19 2004
 BUREAU OF WATER

7 CONTRACTOR'S OR LANDOWNER'S CERTIFICATION: This water well was plugged under my jurisdiction and was completed on (mo/day/year) X 2.5.12, 04 and this record is true to the best of my knowledge and belief. Kansas Water Well Contractor's License No. This Water Well Record was completed on (mo/day/year)
 by (signature) X Bryce Davidson under the business name of

INSTRUCTIONS: Use typewriter or ball point pen. Please press firmly and print clearly. Please fill in blanks, underline or circle the correct answers. Send top three copies to Kansas Department of Health and Environment, Bureau of Water, Topeka, Kansas 66620-0001. Telephone: 785/296-3565. Send one to Water Well Owner and retain one for your records.