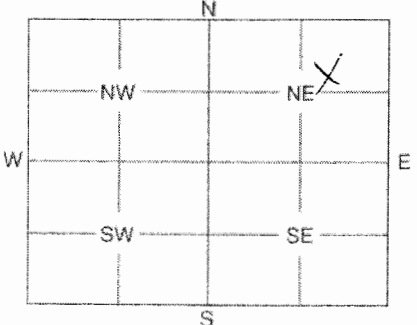


Irwin A

1	LOCATION OF WATER WELL: Russell	Fraction $\frac{1}{4}$ $\frac{1}{4}$ NE $\frac{1}{4}$	Section Number 8	Township Number 15	Range Number 12W
---	---	--	----------------------------	------------------------------	----------------------------

Distance and direction from nearest town or city street address of well if located within city?
4 1/2 Miles S of Bunker Hill; 2 Miles East; 2 miles S and 1/2 M West

2	WATER WELL OWNER: National Cooperative REfinery	RR #, St. Address, Box #: P.O. Box 1404	Board of Agriculture, Division of Water Resources
	City, State, ZIP Code: McPherson, Ks 67460	Application Number:	

3	MARK WELL'S LOCATION WITH AN "X" IN SECTION BOX: 	4	DEPTH OF WELL 15 ft. WELL'S STATIC WATER LEVEL .. 7.50 ft. WELL WAS USED AS: <table border="0"> <tr> <td>1 Domestic</td> <td>5 Public Water Supply</td> <td><input type="checkbox"/> Dewatering</td> </tr> <tr> <td>2 Irrigation</td> <td>6 Oil Field Water Supply</td> <td><input checked="" type="checkbox"/> Monitoring Well</td> </tr> <tr> <td>3 Feedlot</td> <td>7 Domestic (Lawn & Garden)</td> <td>11 Injection Well</td> </tr> <tr> <td>4 Industrial</td> <td>8 Air Conditioning</td> <td>12 Other</td> </tr> </table>	1 Domestic	5 Public Water Supply	<input type="checkbox"/> Dewatering	2 Irrigation	6 Oil Field Water Supply	<input checked="" type="checkbox"/> Monitoring Well	3 Feedlot	7 Domestic (Lawn & Garden)	11 Injection Well	4 Industrial	8 Air Conditioning	12 Other
1 Domestic	5 Public Water Supply	<input type="checkbox"/> Dewatering													
2 Irrigation	6 Oil Field Water Supply	<input checked="" type="checkbox"/> Monitoring Well													
3 Feedlot	7 Domestic (Lawn & Garden)	11 Injection Well													
4 Industrial	8 Air Conditioning	12 Other													
		Was a chemical / bacteriological sample submitted to Department? Yes No X If yes, mo/day/yr sample was submitted													
		Water Well Disinfected: Yes No X													

5	TYPE OF BLANK CASING USED: <table border="0"> <tr> <td><input type="checkbox"/> Steel</td> <td><input type="checkbox"/> RMP (SR)</td> <td><input type="checkbox"/> Wrought</td> <td><input type="checkbox"/> Fiberglass</td> <td><input type="checkbox"/> Other (Specify below)</td> </tr> <tr> <td><input checked="" type="checkbox"/> PVC</td> <td><input type="checkbox"/> ABS</td> <td><input type="checkbox"/> Asbestos-Cement</td> <td><input type="checkbox"/> Concrete Tile</td> <td></td> </tr> </table>	<input type="checkbox"/> Steel	<input type="checkbox"/> RMP (SR)	<input type="checkbox"/> Wrought	<input type="checkbox"/> Fiberglass	<input type="checkbox"/> Other (Specify below)	<input checked="" type="checkbox"/> PVC	<input type="checkbox"/> ABS	<input type="checkbox"/> Asbestos-Cement	<input type="checkbox"/> Concrete Tile	
<input type="checkbox"/> Steel	<input type="checkbox"/> RMP (SR)	<input type="checkbox"/> Wrought	<input type="checkbox"/> Fiberglass	<input type="checkbox"/> Other (Specify below)							
<input checked="" type="checkbox"/> PVC	<input type="checkbox"/> ABS	<input type="checkbox"/> Asbestos-Cement	<input type="checkbox"/> Concrete Tile								
Blank casing diameter in. Was casing pulled? Yes X No If yes, how much 15											
Casing height above or below land surface 0 in.											

6	GROUT PLUG MATERIAL: <table border="0"> <tr> <td><input type="checkbox"/> Neat cement</td> <td><input type="checkbox"/> Cement grout</td> <td><input checked="" type="checkbox"/> Bentonite</td> <td><input type="checkbox"/> Other Surface silts and clays</td> </tr> </table>	<input type="checkbox"/> Neat cement	<input type="checkbox"/> Cement grout	<input checked="" type="checkbox"/> Bentonite	<input type="checkbox"/> Other Surface silts and clays																		
<input type="checkbox"/> Neat cement	<input type="checkbox"/> Cement grout	<input checked="" type="checkbox"/> Bentonite	<input type="checkbox"/> Other Surface silts and clays																				
Grout Plug Intervals: From 3 15 ft. to 3 ft. From 3 ft. to GS ft. From to ft.																							
What is the nearest source of possible contamination: <table border="0"> <tr> <td>1 Septic tank</td> <td>6 Seepage pit</td> <td>11 Fuel storage</td> <td><input checked="" type="checkbox"/> Other (specify below) cont. site</td> </tr> <tr> <td>2 Sewer lines</td> <td>7 Pit privy</td> <td>12 Fertilizer storage</td> <td></td> </tr> <tr> <td>3 Watertight sewer lines</td> <td>8 Sewage lagoon</td> <td>13 Insecticide storage</td> <td></td> </tr> <tr> <td>4 Lateral lines</td> <td>9 Feedyard</td> <td>14 Abandoned water well</td> <td></td> </tr> <tr> <td>5 Cess pool</td> <td>10 Livestock pens</td> <td>15 Oil well/Gas well</td> <td></td> </tr> </table>				1 Septic tank	6 Seepage pit	11 Fuel storage	<input checked="" type="checkbox"/> Other (specify below) cont. site	2 Sewer lines	7 Pit privy	12 Fertilizer storage		3 Watertight sewer lines	8 Sewage lagoon	13 Insecticide storage		4 Lateral lines	9 Feedyard	14 Abandoned water well		5 Cess pool	10 Livestock pens	15 Oil well/Gas well	
1 Septic tank	6 Seepage pit	11 Fuel storage	<input checked="" type="checkbox"/> Other (specify below) cont. site																				
2 Sewer lines	7 Pit privy	12 Fertilizer storage																					
3 Watertight sewer lines	8 Sewage lagoon	13 Insecticide storage																					
4 Lateral lines	9 Feedyard	14 Abandoned water well																					
5 Cess pool	10 Livestock pens	15 Oil well/Gas well																					
Direction from well?		How many feet?																					

FROM	TO	PLUGGING MATERIALS
0	3	Surface silt/clay
15	3	Bentonite

7	CONTRACTOR'S OF LANDOWNER'S CERTIFICATION: This water well was plugged under my jurisdiction and was completed on (mo/day/year) 03/05/05 and this record is true to the best of my knowledge and belief. Kansas Water Well Contractor's License No. 585 This Water Well Record was completed on (mo/day/year) 03/21/05 under the business name of Associated Environmental, Inc. by (signature) Darin Duncan
---	---

INSTRUCTIONS: Use typewriter or ball point pen. Please press firmly and print clearly. Please fill in blanks, underline or circle the correct answers. Send top three copies to Kansas Department of Health and Environment, Bureau of Water, Geology Section, 1000 SW Jackson St., Ste. 420, Topeka, Kansas 66612-1367. Telephone: 785/296-5522. Send one to Water Well Owner and retain one for your records.