


1 LOCATION OF WATER WELL:		Fraction		Section Number		Township Number		Range Number	
County: RUSSELL		SE 1/4 SE 1/4 SE 1/4		30		T 15 S		R 13 EW	

Distance and direction from nearest town or city street address of well if located within city?
SIX MI. EAST OF MILBERGER MW-1

2 WATER WELL OWNER: CONOCO INC.
RR#, St. Address, Box # : 600 N. DAIRY ASHFORD
City, State, ZIP Code : HOUSTON, TX 77252

3 LOCATE WELL'S LOCATION WITH AN "X" IN SECTION BOX: 4 DEPTH OF COMPLETED WELL: 10.0 ft. ELEVATION:
Depth(s) Groundwater Encountered 1. 8.5 ft. 2. ft. 3. ft.

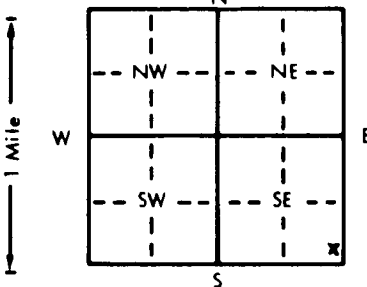

4 DEPTH OF COMPLETED WELL 10.0 ft. ELEVATION:
 Depth(s) Groundwater Encountered 1. 8.5 ft. 2. ft. 3. ft.
 WELL'S STATIC WATER LEVEL 5.19 ft. below land surface measured on mo/day/yr 4-19-91
 Pump test data: Well water was ft. after hours pumping gpm
 Est. Yield gpm: Well water was ft. after hours pumping gpm
 Bore Hole Diameter 6.25 in. to 10.0 ft., and in. to ft.
 WELL WATER TO BE USED AS: 5 Public water supply 8 Air conditioning 11 Injection well
 1 Domestic 3 Feedlot 6 Oil field water supply 9 Dewatering 12 Other (Specify below)
 2 Irrigation 4 Industrial 7 Lawn and garden only 10 Monitoring well
 Was a chemical/bacteriological sample submitted to Department? Yes No; If yes, mo/day/yr sample was submitted
 Water Well Disinfected? Yes No

5	TYPE OF BLANK CASING USED:		5 Wrought iron	8 Concrete tile	CASING JOINTS: Glued Clamped Welded Threaded
	1 Steel	3 RMP (SR)	6 Asbestos-Cement	9 Other (specify below)	
	2 PVC	4 ABS	7 Fiberglass		

Blank casing diameter 2.0 in. to 3.0 ft. Dia. in. to . ft. Dia. in. to . ft.
Casing height above land surface 3.33 in. weight lbs./ft. Wall thickness or gauge No. SCH 40

TYPE OF SCREEN OR PERFORATION MATERIAL:

1 Steel	3 Stainless steel	5 Fiberglass	7 PVC	10 Asbestos-cement
2 Brass	4 Galvanized steel	6 Concrete tile	8 RMP (SR)	11 Other (specify)
			9 ABS	12 None used (open hole)

SCREEN OR PERFORATION OPENINGS ARE:

1 Continuous slot	3 Mill slot	5 Gauzed wrapped	8 Saw cut	11 None (open hole)
2 Louvered shutter	4 Key punched	6 Wire wrapped	9 Drilled holes	
		7 Torch cut	10 Other (specify)	

SCREEN-PERFORATED INTERVALS:	From 1.0 ft. to 10.0 ft.,	From ft. to ft.
	From ft. to ft.,	From ft. to ft.
GRAVEL PACK INTERVALS:	From 10.0 ft. to 1.0 ft.,	From ft. to ft.
	From ft. to ft.,	From ft. to ft.

6 GROUT MATERIAL: 1 Neat cement 2 Cement grout 3 Bentonite 4 Other
Grout Intervals: From 3 1.0 ft. to 2 2.0 ft. From 1 0.0 ft. to 4 +1.0 ft. From ft. to ft.

What is the nearest source of possible contamination:

1 Septic tank	4 Lateral lines	7 Pit privy	10 Livestock pens	14 Abandoned water well
2 Sewer lines	5 Cess pool	8 Sewage lagoon	11 Fuel storage	15 Oil well/Gas well
3 Watertight sewer lines	6 Seepage pit	9 Feedyard	12 Fertilizer storage	16 Other (specify below)
			13 Insecticide storage	

Direction from well? W How many feet? 15'

[illegible]

7 CONTRACTOR'S OR LANDOWNER'S CERTIFICATION: This water well was (1) constructed, (2) reconstructed, or (3) plugged under my jurisdiction and was completed on (mo/day/year) 4-19-91 and this record is true to the best of my knowledge and belief. Kansas Water Well Contractor's License No. 517 This Water Well Record was completed on (mo/day/yr) 5-11-91 under the business name of GROUNDWATER TECHNOLOGY by (signature) Albert Stout