


|                           |  |                             |                |                 |                          |
|---------------------------|--|-----------------------------|----------------|-----------------|--------------------------|
| 1 LOCATION OF WATER WELL: |  | Fraction                    | Section Number | Township Number | Range Number             |
| County: <b>RUSSELL</b>    |  | <b>SE 1/4 SE 1/4 SE 1/4</b> | <b>30</b>      | <b>T 15 S</b>   | <b>R 13 E</b> <b>(W)</b> |

Distance and direction from nearest town or city street address of well if located within city? 6 MI EAST OF MILBERGER MW-3

2 WATER WELL OWNER: CONOCO INC.  
RR#, St. Address, Box # : 600 N. DAIRY ASHFORD  
City, State, ZIP Code : HOUSTON TX 77252

3 LOCATE WELL'S LOCATION WITH AN "X" IN SECTION BOX: 4 DEPTH OF COMPLETED WELL: 20.0 ft. ELEVATION: . . . . .  
Depth(s) Groundwater Encountered 1. 13.0 ft. 2. . . . . ft. 3. . . . . ft.

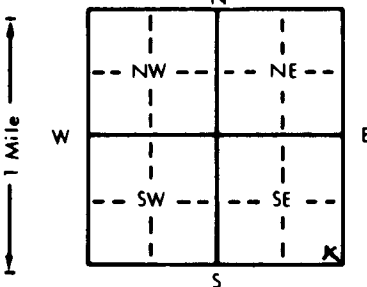

4. DEPTH OF COMPLETED WELL. 20.0 ft. ELEVATION: \_\_\_\_\_  
 Depth(s) Groundwater Encountered 1. 13.0 ft. 2. \_\_\_\_\_ ft. 3. \_\_\_\_\_ ft.  
 WELL'S STATIC WATER LEVEL 8.97 ft. below land surface measured on mo/day/yr 4-19-91  
 Pump test data: Well water was \_\_\_\_\_ ft. after \_\_\_\_\_ hours pumping \_\_\_\_\_ gpm  
 Est. Yield \_\_\_\_\_ gpm: Well water was \_\_\_\_\_ ft. after \_\_\_\_\_ hours pumping \_\_\_\_\_ gpm  
 Bore Hole Diameter. 6.25 in. to 20.0 ft., and \_\_\_\_\_ in. to \_\_\_\_\_ ft.  
 WELL WATER TO BE USED AS:  
     1 Domestic      3 Feedlot      6 Oil field water supply      9 Dewatering      11 Injection well  
     2 Irrigation    4 Industrial    7 Lawn and garden only    10 Monitoring well    12 Other (Specify below) \_\_\_\_\_  
 Was a chemical/bacteriological sample submitted to Department? Yes \_\_\_\_\_ (No) \_\_\_\_\_; If yes, mo/day/yr sample was submitted \_\_\_\_\_  
 Water Well Disinfected? Yes \_\_\_\_\_ (No) \_\_\_\_\_

|   |                            |            |                   |                         |                                                                      |
|---|----------------------------|------------|-------------------|-------------------------|----------------------------------------------------------------------|
| 5 | TYPE OF BLANK CASING USED: |            | 5 Wrought iron    | 8 Concrete tile         | CASING JOINTS: Glued . . . . . Clamped . . . . .<br>Welded . . . . . |
|   | 1 Steel                    | 3 RMP (SR) | 6 Asbestos-Cement | 9 Other (specify below) |                                                                      |

Blank casing diameter 2.0 in. to 5.0 ft. Dia. 2 PVC 4 ABS 7 Fiberglass Threaded in. to ft.  
Casing height above land surface 3.25' in. weight lbs./ft. Wall thickness or gauge No. SCH 40

TYPE OF SCREEN OR PERFORATION MATERIAL:

|         |                    |                 |            |                          |
|---------|--------------------|-----------------|------------|--------------------------|
| 1 Steel | 3 Stainless steel  | 5 Fiberglass    | 7 PVC      | 10 Asbestos-cement       |
| 2 Brass | 4 Galvanized steel | 6 Concrete tile | 8 RMP (SR) | 11 Other (specify) ..... |
|         |                    |                 | 9 ABS      | 12 None used (open hole) |

SCREEN OR PERFORATION OPENINGS ARE:

|                    |               |                  |                          |                     |
|--------------------|---------------|------------------|--------------------------|---------------------|
| 1 Continuous slot  | 3 Mill slot   | 5 Gauzed wrapped | 8 Saw cut                | 11 None (open hole) |
| 2 Louvered shutter | 4 Key punched | 6 Wire wrapped   | 9 Drilled holes          |                     |
|                    |               | 7 Torch cut      | 10 Other (specify) ..... |                     |

SCREEN-PERFORATED INTERVALS: From 20.0 ft. to 5.0 ft., From . ft. to . ft.  
From . ft. to . ft., From . ft. to . ft.  
GRAVEL PACK INTERVALS: From 20.0 ft. to 4.0 ft., From . ft. to . ft.  
From . ft. to . ft., From . ft. to . ft.

6 GROUT MATERIAL: (1) Neat cement 2 Cement grout (3) Bentonite 4 Other  
Grout Intervals: From (3) 4 ft. to 1.0 ft. From (1) 1.0 ft. to + 1.0 ft. From ft. to ft.

What is the nearest source of possible contamination:

|                          |                 |                 |                        |                          |
|--------------------------|-----------------|-----------------|------------------------|--------------------------|
| 1 Septic tank            | 4 Lateral lines | 7 Pit privy     | 10 Livestock pens      | 14 Abandoned water well  |
| 2 Sewer lines            | 5 Cess pool     | 8 Sewage lagoon | <b>11 Fuel storage</b> | 15 Oil well/Gas well     |
| 3 Watertight sewer lines | 6 Seepage pit   | 9 Feedyard      | 12 Fertilizer storage  | 16 Other (specify below) |
|                          |                 |                 | 13 Insecticide storage |                          |

Direction from well? **NE** How many feet? **75**

[illegible]

7 CONTRACTOR'S OR LANDOWNER'S CERTIFICATION: This water well was (1) constructed, (2) reconstructed, or (3) plugged under my jurisdiction and was completed on (mo/day/year) 4-19-91 and this record is true to the best of my knowledge and belief. Kansas Water Well Contractor's License No. 517 This Water Well Record was completed on (mo/day/yr) 5-11-91 under the business name of GROUNDWATER TECHNOLOGY by (signature) Alvin Stovett