WATER WELL PLUGGING RECORD Form WWC-5P KSA 82a-1212 ID NO. _____

1 LOCATION OF WATER WELL:	Fraction	Section Number	Township Number	Range Number
County: Russell	NE ¼ NE ¼ SE ¼	30	15	14 E/W

Distance and direction from nearest town or city street address of well if located within city?
1/4 mile S North of Milberger

2 WATER WELL OWNER: United Emanuel Lutheran Church
RR #, St. Address, Box #: 3130 182nd St.
City, State, ZIP Code : Russell, KS 67665
Board of Agriculture, Division of Water Resources
Application Number:

3 MARK WELL'S LOCATION WITH AN "X" IN SECTION BOX:

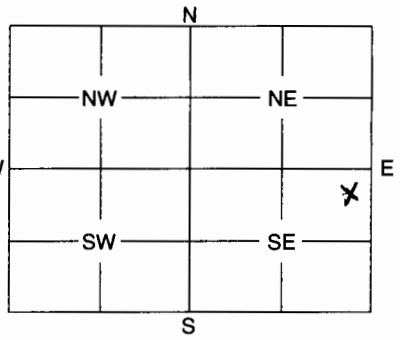

4 DEPTH OF WELL 45 ft.
WELL'S STATIC WATER LEVEL 38 ft.

WELL WAS USED AS:

1 Domestic	5 Public Water Supply	9 Dewatering
2 Irrigation	6 Oil Field Water Supply	10 Monitoring Well
3 Feedlot	7 Domestic (Lawn & Garden)	11 Injection Well
4 Industrial	8 Air Conditioning	12 Other Abandoned

Was a chemical / bacteriological sample submitted to Department? Yes ..... No X
If yes, mo/day/yr sample was submitted .....

Water Well Disinfected: Yes X No .....

5 TYPE OF BLANK CASING USED:

1 Steel	3 RMP (SR)	5 Wrought	7 Fiberglass	9 Other (Specify below)
2 PVC	4 ABS	6 Asbestos-Cement	8 Concrete Tile	

Blank casing diameter 5 in. Was casing pulled? Yes X No ..... If yes, how much 36"
Casing height above or below land surface 36" in.

6 GROUT PLUG MATERIAL: X Neat cement 2 Cement grout 3 Bentonite 4 Other .....
Grout Plug Intervals: From 15 ft. to 3 ft., From ..... ft. to ..... ft., From ..... to ..... ft.

What is the nearest source of possible contamination:

X Septic tank	X Seepage pit	11 Fuel storage	16 Other (specify below)
X Sewer lines	7 Pit privy	12 Fertilizer storage	.....
X Watertight sewer lines	8 Sewage lagoon	13 Insecticide storage	
X Lateral lines	9 Feedyard	X Abandoned water well	
5 Cess pool	10 Livestock pens	15 Oil well/Gas well	

Direction from well? North How many feet? 20'

FROM	TO	PLUGGING MATERIALS
45	15	SAND
15	3	Neat Cement
3	0	Compacted Clay

7 CONTRACTOR'S OR LANDOWNER'S CERTIFICATION: This water well was plugged under my jurisdiction and was completed on (mo/day/year) 7-16-04 and this record is true to the best of my knowledge and belief. Kansas Water Well Contractor's License No. ..... This Water Well Record was completed on (mo/day/year) ..... under the business name of .....
by (signature) X .....

INSTRUCTIONS: Use typewriter or ball point pen. Please press firmly and print clearly. Please fill in blanks, underline or circle the correct answers. Send top three copies to Kansas Department of Health and Environment, Bureau of Water, Geology Section, 1000 SW Jackson St., Ste. 420, Topeka, Kansas 66612-1367. Telephone: 785/296-5522. Send one to Water Well Owner and retain one for your records.