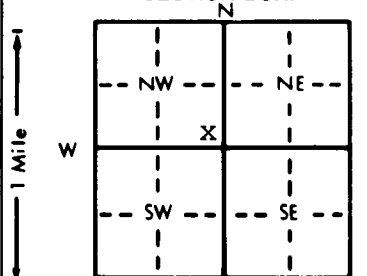


1 LOCATION OF WATER WELL: County: <u>Ellis</u>	Fraction <u>SE 1/4 SE 1/4 NW 1/4</u>	Section Number <u>36</u>	Township Number <u>T 15 S</u>	Range Number <u>R 17 E/W</u>
---	---	-----------------------------	----------------------------------	---------------------------------

Distance and direction from nearest town or city street address of well if located within city?
Pfeifer, Kansas

2 WATER WELL OWNER: Randy Jordan
 RR#, St. Address, Box # : 1604 Sarratov Street Board of Agriculture, Division of Water Resources
 City, State, ZIP Code : Victoria, Kansas 67671 Application Number:

3 LOCATE WELL'S LOCATION WITH AN "X" IN SECTION BOX: 	4 DEPTH OF COMPLETED WELL... <u>35</u> ft. ELEVATION: <u>Valley</u>
	Depth(s) Groundwater Encountered 1. <u>6</u> ft. 2. <u>6</u> ft. 3. <u>6</u> ft.
	WELL'S STATIC WATER LEVEL <u>18</u> ft. below land surface measured on mo/day/yr <u>3/11/96</u>
	Pump test data: Well water was <u>18</u> ft. after <u>1</u> hours pumping <u>10</u> gpm
	Est. Yield <u>10</u> gpm: Well water was <u>18</u> ft. after <u>1</u> hours pumping <u>10</u> gpm
Bore Hole Diameter <u>10</u> in. to <u>35</u> ft., and <u>10</u> in. to <u>35</u> ft.	
WELL WATER TO BE USED AS: 1 <u>Domestic</u> 5 <u>Public water supply</u> 8 <u>Air conditioning</u> 11 <u>Injection well</u> 2 <u>Irrigation</u> 3 <u>Feedlot</u> 6 <u>Oil field water supply</u> 9 <u>Dewatering</u> 12 <u>Other (Specify below)</u> 7 <u>Lawn and garden only</u> 10 <u>Monitoring well</u>	
Was a chemical/bacteriological sample submitted to Department? Yes <u>No</u> <u>X</u> No <u>X</u> If yes, mo/day/yr sample was submitted	
Water Well Disinfected? Yes <u>X</u> No <u>No</u>	

5 TYPE OF BLANK CASING USED: 2 Steel 3 RMP (SR) 4 ABS 5 Wrought iron 6 Asbestos-Cement 7 Fiberglass 8 Concrete tile 9 Other (specify below)

CASING JOINTS: Glued X Clamped No Welded No Threaded No

Blank casing diameter 5 in. to 15 ft., Dia 5 in. to 15 ft., Dia 5 in. to 15 ft.

Casing height above land surface 24 in., weight 2.29 lbs./ft. Wall thickness or gauge No. 26

TYPE OF SCREEN OR PERFORATION MATERIAL: 7 PVC 10 Asbestos-cement
 1 Steel 3 Stainless steel 5 Fiberglass 8 RMP (SR) 11 Other (specify)
 2 Brass 4 Galvanized steel 6 Concrete tile 9 ABS 12 None used (open hole)

SCREEN OR PERFORATION OPENINGS ARE: 8 Continuous slot 3 Mill slot 5 Gauzed wrapped 8 Saw cut 11 None (open hole)
 2 Louvered shutter 4 Key punched 6 Wire wrapped 9 Drilled holes
 7 Torch cut 10 Other (specify)





What is the nearest source of possible contamination: None 10 Livestock pens 14 Abandoned water well
 1 Septic tank 4 Lateral lines 7 Pit privy 11 Fuel storage 15 Oil well/Gas well
 2 Sewer lines 5 Cess pool 8 Sewage lagoon 12 Fertilizer storage 16 Other (specify below)
 3 Watertight sewer lines 6 Seepage pit 9 Feedyard 13 Insecticide storage

Direction from well?			How many feet?		
FROM	TO	LITHOLOGIC LOG	FROM	TO	PLUGGING INTERVALS
0	6	Topsoil			
6	10	Fine sand			
10	19	Coarse sand			
19	35	Hard shale			

7 CONTRACTOR'S OR LANDOWNER'S CERTIFICATION: This water well was (1) constructed, (2) reconstructed, or (3) plugged under my jurisdiction and was completed on (mo/day/year) 3/11/96 and this record is true to the best of my knowledge and belief. Kansas Water Well Contractor's License No. 199 This Water Well Record was completed on (mo/day/yr) 3/22/96 under the business name of Karst Water Well Drilling & Service, Inc by (signature) [Signature]

INSTRUCTIONS: Use typewriter or ball point pen. PLEASE PRESS FIRMLY and PRINT clearly. Please fill in blanks, underline or circle the correct answers. Send top three copies to Kansas Department of Health and Environment, Bureau of Water, Topeka, Kansas 66620-0001. Telephone: 913-296-5545. Send one to WATER WELL OWNER and retain one for your records.