USE TYPEWRITER OR BALL POINT PEN-PRESS FIRMLY, PRINT CLEARLY.

WATER WELL RECORD
KSA 82a-1201-1215

Kansas Department of Health and Environment-Division of Environment
(Water well Contractors)
Topeka, Kansas 66620

Zimmer #1

1. Location of well:	County: Ellis	Fraction: NW SE SW (1/4 1/4 1/4)	Section number: 31	Township number: T 15 S	Range number: R 17 E/W

2. Distance and direction from nearest town or city: 3 east ½ north
Street address of well location if in city: Shenshon

3. Owner of well: DNB Drilling Co
R.R. or street:
City, state, zip code: Wichita KS

4. Locate with "X" in section below:

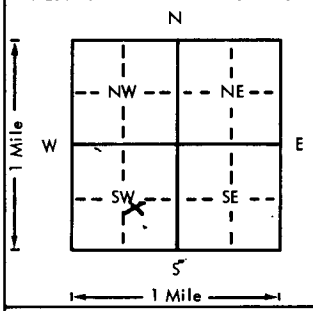

Sketch map:

6. Bore hole dia. 8 in. Completion date
Well depth 40 ft. Feb 3-78

7. __ Cable tool X Rotary __ Driven __ Dug
__ Hollow rod __ Jetted __ Bored __ Reverse rotary

8. Use: __ Domestic __ Public supply __ Industry
__ Irrigation __ Air conditioning __ Stock
__ Lawn X Oil field water __ Other

9. Casing: Material Plastic Height: Above or below
Threaded __ Welded X Surface 12 in.
RMP __ PVC X Weight 287.3 lbs./ft.
Dia. __ in. to __ ft. depth Wall Thickness: inches or
Dia. __ in. to __ ft. depth gage No. 200

5. Type and color of material	From	To
Sand	0	6
Post rock	6	8
Shale	8	40

(Use a second sheet if needed)

10. Screen: Manufacturer's name
no Pipe run
Type Dia.
Slot/gauze Length
Set between ft. and ft.
ft. and ft.
Gravel pack? Size range of material

11. Static water level: no water mo./day/yr.
ft. below land surface Date

12. Pumping level below land surfaces:
ft. after hrs. pumping g.p.m.
ft. after hrs. pumping g.p.m.
Estimated maximum yield g.p.m.

13. Water sample submitted: mo./day/yr.
Yes No Date

14. Well head completion:
Pitless adapter Inches above grade

15. Well grouted?
With: Neat cement Bentonite Concrete
Depth: From ft. to ft.

16. Nearest source of possible contamination:
ft. Direction Type
Well disinfected upon completion? Yes No

17. Pump: X Not installed
Manufacturer's name
Model number HP Volts
Length of drop pipe ft. capacity g.p.m.
Type:
Submersible Turbine
Jet Reciprocating
Centrifugal Other

18. Elevation:
Topography:
Hill
Slope
Upland
Valley

19. Remarks:
no Pipe Ran
Dry Hole
Plug & Cement Hole

20. Water well contractor's certification:
This well was drilled under my jurisdiction and this report is true to the best of my knowledge and belief.
Business name Myers Maturell
Address Hutchinson Ks License No. 143
Signed R Myers Date 2-3-78
Authorized representative

T 15 R 17 E/W Sec 31 1/4 NW 1/4 SE 1/4 SW

Forward the white, blue and pink copies to the Department of Health and Environment

Form WWC-5

MI-1023