WATER WELL RECORD Form WWC-5 KSA 82a-1212 ID No. 0529

1 LOCATION OF WATER WELL:	Fraction	Section Number	Township Number	Range Number
County: Ellis	SE ¼ SE ¼ NW ¼	36	T 15 S	R 17 E/W

Distance and direction from nearest town or city street address of well if located within city?

South end of Pfeifer, east side

2 WATER WELL OWNER: Damon Breit

RR#, St. Address, Box #: 228 Northridge Dr

City, State, ZIP Code: Hays KS 67601

Board of Agriculture, Division of Water Resources Application Number:

3 LOCATE WELL'S LOCATION WITH AN "X" IN SECTION BOX:

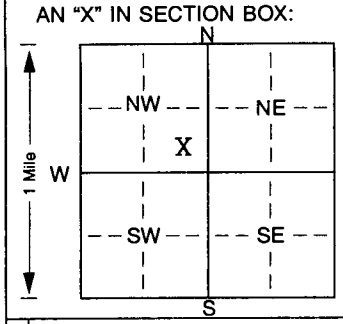

4 DEPTH OF COMPLETED WELL 35 ft. ELEVATION: valley

Depth(s) Groundwater Encountered 1. 12 ft. 2. ft. 3. ft.

WELL'S STATIC WATER LEVEL 17 ft. below land surface measured on mo/day/yr 8/17/01

Pump test data: Well water was 17 ft. after 2 hours pumping 10 gpm

Est. Yield 10 gpm: Well water was ft. after hours pumping gpm

Bore Hole Diameter 10 in. to 35 ft., and in. to ft.

WELL WATER TO BE USED AS: 1 Domestic; 2 Irrigation; 3 Feedlot; 4 Industrial; 5 Public water supply; 6 Oil field water supply; 7 Domestic (lawn & garden); 8 Air conditioning; 9 Dewatering; 10 Monitoring well; 11 Injection well; 12 Other (Specify below)

Was a chemical/bacteriological sample submitted to Department? Yes No X; If yes, mo/day/yrs sample was submitted

Water Well Disinfected? Yes X No

5 TYPE OF BLANK CASING USED: 2

1 Steel; 2 PVC; 3 RMP (SR); 4 ABS; 5 Wrought iron; 6 Asbestos-Cement; 7 Fiberglass; 8 Concrete tile; 9 Other (specify below)

CASING JOINTS: Glued X Clamped; Welded; Threaded

Blank casing diameter 5 in. to 15 ft., Dia in. to ft., Dia in. to ft.

Casing height above land surface 24 in., weight 2.29 lbs./ft. Wall thickness or gauge No. .26

TYPE OF SCREEN OR PERFORATION MATERIAL: 7

1 Steel; 2 Brass; 3 Stainless steel; 4 Galvanized steel; 5 Fiberglass; 6 Concrete tile; 7 PVC; 8 RMP (SR); 9 ABS; 10 Asbestos-cement; 11 Other (specify); 12 None used (open hole)

SCREEN OR PERFORATION OPENINGS ARE: 8

1 Continuous slot; 2 Louvered shutter; 3 Mill slot; 4 Key punched; 5 Gauzed wrapped; 6 Wire wrapped; 7 Torch cut; 8 Saw cut; 9 Drilled holes; 10 Other (specify); 11 None (open hole)

SCREEN-PERFORATED INTERVALS: From 35 ft. to 15 ft., From ft. to ft.

From ft. to ft., From ft. to ft.

GRAVEL PACK INTERVALS: From 15 ft. to 35 ft., From ft. to ft.

From ft. to ft., From ft. to ft.

6 GROUT MATERIAL: 3

1 Neat cement; 2 Cement grout; 3 Bentonite; 4 Other

Grout Intervals: From 0 ft. to 15 ft., From ft. to ft., From ft. to ft.

What is the nearest source of possible contamination:

1 Septic tank; 2 Sewer lines; 3 Watertight sewer lines; 4 Lateral lines; 5 Cess pool; 6 Seepage pit; 7 Pit privy; 8 Sewage lagoon; 9 Feedyard; 10 Livestock pens; 11 Fuel storage; 12 Fertilizer storage; 13 Insecticide storage; 14 Abandoned water well; 15 Oil well/Gas well; 16 Other (specify below)

Direction from well? How many feet?

FROM	TO	LITHOLOGIC LOG	FROM	TO	PLUGGING INTERVALS
0	2	Topsoil			
2	12	Gumbo			
12	23	Sand			
23	35	Shale			

7 CONTRACTOR'S OR LANDOWNER'S CERTIFICATION: This water well was (1) constructed, (2) reconstructed, or (3) plugged under my jurisdiction and was completed on (mo/day/year) 8/28/01 and this record is true to the best of my knowledge and belief. Kansas Water Well Contractor's Licence No. 199 This Water Well Record was completed on (mo/day/yr) 9/25/01 under the business name of Karst Water Well Drilling & Service, Inc. by (signature) [signature]

INSTRUCTIONS: Use typewriter or ball point pen. *PLEASE PRESS FIRMLY* and *PRINT* clearly. Please fill in blanks, underline or circle the correct answers. Send top three copies to Kansas Department of Health and Environment, Bureau of Water, Topeka, Kansas 66620-0001. Telephone 785-296-5524. Send one to WATER WELL OWNER and retain one for your records. Fee of $5.00 for each constructed well.