


|                                  |                             |           |        |           |        |           |            |
|----------------------------------|-----------------------------|-----------|--------|-----------|--------|-----------|------------|
| <b>1</b> LOCATION OF WATER WELL: | Fraction                    | Section   | Number | Township  | Number | Range     | Number     |
| County: <u>Ellis</u>             | <u>SW 1/4 SW 1/4 NE 1/4</u> | <u>33</u> |        | <u>15</u> |        | <u>17</u> | <u>R/W</u> |

Distance and direction from nearest town or city street address of well if located within city?

2 1/2 West of Pfeifer, Ks.

**2** WATER WELL OWNER: Lillian Zimmerman Leiker  
 RR #, St. Address, Box #: 211 Church St.  
 City, State, ZIP Code : Schoenchen, Ks. 67667  
 Board of Agriculture, Division of Water Resources  
 Application Number: 34505

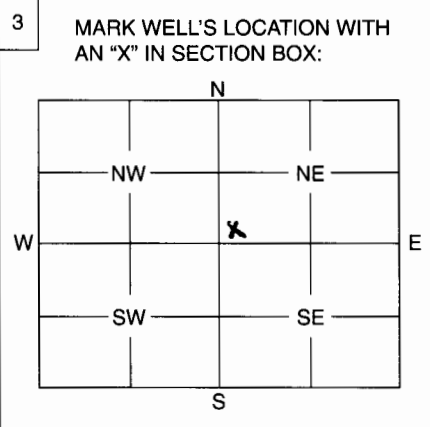

**4** DEPTH OF WELL .....56..... ft.  
 WELL'S STATIC WATER LEVEL .....22..... ft.  
 WELL WAS USED AS:

|                     |                            |                    |
|---------------------|----------------------------|--------------------|
| 1 Domestic          | 5 Public Water Supply      | 9 Dewatering       |
| 2 <u>Irrigation</u> | 6 Oil Field Water Supply   | 10 Monitoring Well |
| 3 Feedlot           | 7 Domestic (Lawn & Garden) | 11 Injection Well  |
| 4 Industrial        | 8 Air Conditioning         | 12 Other .....     |

Was a chemical / bacteriological sample submitted to Department? Yes ..... No X.....  
 If yes, mo/day/yr sample was submitted .....

Water Well Disinfected: Yes HTH No .....

**5** TYPE OF BLANK CASING USED:

|              |            |                   |                 |                         |
|--------------|------------|-------------------|-----------------|-------------------------|
| 1 Steel      | 3 RMP (SR) | 5 Wrought         | 7 Fiberglass    | 9 Other (Specify below) |
| 2 <u>PVC</u> | 4 ABS      | 6 Asbestos-Cement | 8 Concrete Tile |                         |

Blank casing diameter .....16 in. Was casing pulled? Yes ..... No X ..... If yes, how much .....

Casing height above or below land surface .....24..... in.

**6** GROUT PLUG MATERIAL: 1 Neat cement 2 Cement grout 3 Bentonite 4 Other hole plug

Grout Plug Intervals: From ..... ft. to ..... ft., From ..... ft. to ..... ft., From 22 to 3 ft.

What is the nearest source of possible contamination:

|                          |                   |                         |                          |
|--------------------------|-------------------|-------------------------|--------------------------|
| 1 Septic tank            | 6 Seepage pit     | 11 Fuel storage         | 16 Other (specify below) |
| 2 Sewer lines            | 7 Pit privy       | 12 Fertilizer storage   | <u>None</u>              |
| 3 Watertight sewer lines | 8 Sewage lagoon   | 13 Insecticide storage  |                          |
| 4 Lateral lines          | 9 Feedyard        | 14 Abandoned water well |                          |
| 5 Cess pool              | 10 Livestock pens | 15 Oil well/Gas well    |                          |

Direction from well? ..... How many feet? .....

| FROM | TO | PLUGGING MATERIALS |
|------|----|--------------------|
| 56   | 22 | Chlorinated gravel |
| 22   | 3  | Cement             |
| 3    | 0  | Top soil           |
|      |    |                    |
|      |    |                    |
|      |    |                    |

**7** CONTRACTOR'S OF LANDOWNER'S CERTIFICATION: This water well was plugged under my jurisdiction and was completed on (mo/day/year) .....5-10-07..... and this record is true to the best of my knowledge and belief. Kansas Water Well Contractor's License No. 134 This Water Well Record was completed on (mo/day/year) .....6-6-07..... under the business name of Rosencrantz- Bemis by (signature) [Signature]

INSTRUCTIONS: Use typewriter or ball point pen. Please press firmly and print clearly. Please fill in blanks, underline or circle the correct answers. Send top three copies to Kansas Department of Health and Environment, Bureau of Water, Geology Section, 1000 SW Jackson St., Ste. 420, Topeka, Kansas 66612-1367. Telephone: 785/296-5522. Send one to Water Well Owner and retain one for your records.