


1 LOCATION OF WATER WELL: Fraction NW 1/4 SW 1/4 NW 1/4 Section Number 36 Township Number 15 Range Number 17 EW

Distance and direction from nearest town or city street address of well if located within city?

1518 SARRATOU ST

2 WATER WELL OWNER: MARRETA PARSONS Global Positioning Systems (decimal degrees, min. of 4 digits)
 RR#, St. Address, Box #: 1518 SARRATOU ST Latitude: _____
 City, State ZIP Code: Pfeifer KS 67640 Longitude: _____
 Elevation: _____
 Datum: _____
 Data Collection Method: _____

3 MARK WELL'S LOCATION WITH AN "X" IN SECTION BOX:

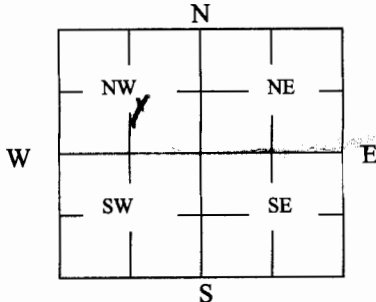

4 DEPTH OF WELL 19 ft.

WELL'S STATIC WATER LEVEL 2 ft

WELL WAS USED AS:

- 1 Domestic
- 2 Irrigation
- 3 Feedlot
- 4 Industrial
- 5 Public Water Supply
- 6 Oil Field Water Supply
- 7 Domestic (Lawn & Garden)
- 8 Air Conditioning
- 9 Dewatering
- 10 Monitoring
- 11 Injection Well
- 12 Other _____

Was a chemical/bacteriological sample submitted to Department? Yes _____ No

5 TYPE OF BLANK CASING USED:
 1 Steel 3 RMP (SR) 5 Wrought 7 Fiberglass 9 Other (Specify below)
 2 PVC 4 ABS 6 Asbestos-Cement 8 Concrete Tile ROCK

Blank casing diameter 36 in. Was casing pulled? Yes No _____ If yes, how much _____
 Casing height above or below land surface 40 in.

6 GROUT PLUG MATERIAL: 1 Neat cement 2 Cement grout 3 Bentonite 4 Other _____

Grout Plug Intervals: From 5 ft. to 4 1/2 ft., From _____ ft. to _____ ft., From _____ to _____ ft.

What is the nearest source of possible contamination:
 1 Septic tank 6 Seepage pit 11 Fuel Storage 16 Other (specify below)
 2 Sewer lines 7 Pit privy 12 Fertilizer storage
 3 Watertight sewer lines 8 Sewage lagoon 13 Insecticide storage
 4 Lateral lines 9 Feedyard 14 Abandoned water well Direction from well? West
 5 Cess pool 10 Livestock pens 15 Oil well/Gas well How many feet? 30'

FROM	TO	PLUGGING MATERIALS	FROM	TO	PLUGGING MATERIALS
<u>19</u>	<u>5</u>	<u>CLAY & ROCK</u>			
<u>5</u>	<u>4 1/2</u>	<u>BENTONITE</u>			<u>HAND DUG WELL</u>
<u>4 1/2</u>	<u>0</u>	<u>CLAY</u>			

7 CONTRACTOR'S OR LANDOWNER'S CERTIFICATION: This water well was plugged under my jurisdiction and was completed on (mo/day/year) 3-12-12 and this record is true to the best of my knowledge and belief. Kansas Water Well Contractor's License No. 626. This Water Well Record was completed on (mo/day/year) 3-20-12 under the business name of Altee by (signature)