

WATER WELL RECORD


Form WWC-5

Division of Water Resources App. No.

1 LOCATION OF WATER WELL: County: Ellis Fraction: 1/4 NW 1/4 SE 1/4 SE 1/4 Section Number: 1 Township No.: T 15 S Range Number: R 17 E W

Street/Rural Address of Well Location; if unknown, distance & direction from nearest town or intersection: If at owner's address, check here [] Approximately 5 miles south and 0.5 miles west of Victoria. Global Positioning System (GPS) information: Latitude: 38.772629 Longitude: -99.154927 Elevation: Unknown

2 WATER WELL OWNER: City of Victoria RR#, Street Address, Box #: 1005 4th St. City, State, ZIP Code : Victoria, KS 67671 Collection Method: [X] GPS unit (Make/Model: WAAS) [] Digital Map/Photo, [] Topographic Map, [] Land Survey

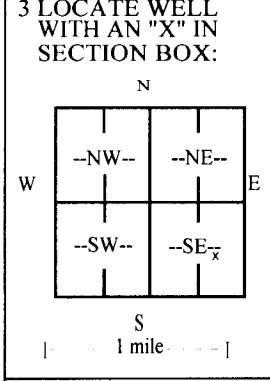

3 LOCATE WELL WITH AN 'X' IN SECTION BOX: 4 DEPTH OF COMPLETED WELL 45 ft. Depth(s) Groundwater Encountered (1) 27.30 ft. (2) ft. (3) ft. WELL'S STATIC WATER LEVEL 27.30 ft. below land surface measured on mo/day/yr 04/11/17 Pump test data: Well water was not checked ft. after hours pumping gpm EST. YIELD gpm. Well water was ft. after hours pumping gpm Bore Hole Diameter 5 in. to 45 ft., and in. to ft. WELL WATER TO BE USED AS: [] Public water supply [] Geothermal [] Injection well [] Domestic [] Feedlot [] Oil field water supply [] Dewatering [] Other (Specify below) [] Irrigation [] Industrial [] Domestic-lawn & garden [X] Monitoring well Was a chemical/bacteriological sample submitted to Department? [] Yes [X] No If yes, mo/day/yr sample was submitted Water well disinfected? [X] Yes [] No

5 TYPE OF CASING USED: [] Steel [X] PVC [] Other CASING JOINTS: [X] Glued [] Clamped [] Welded [] Threaded [] Other (Specify) Casing diameter 2 in. to 38 ft., Diameter in. to ft., Diameter in. to ft., Diameter in. to ft. Casing height above land surface 24 in., Weight .70 lbs./ft., Wall thickness or gauge No. .154 TYPE OF SCREEN OR PERFORATION MATERIAL: [] Steel [] Stainless Steel [X] PVC [] Other (Specify) [] Brass [] Galvanized Steel [] None used (open hole) SCREEN OR PERFORATION OPENINGS ARE: [] Continuous slot [X] Mill slot [] Gauze wrapped [] Torch cut [] Drilled holes [] None (open hole) [] Louvered shutter [] Key punched [] Wire wrapped [] Saw cut [] Other (specify) SCREEN-PERFORATED INTERVALS: From 38 ft. to 43 ft., From ft. to ft. ft. GRAVEL PACK INTERVALS: From 23 ft. to 45 ft., From ft. to ft. ft.

6 GROUT MATERIAL: [] Neat cement [] Cement grout [X] Bentonite [] Other Grout Intervals: From 3 ft. to 23 ft., From ft. to ft. ft., From ft. to ft. ft. What is the nearest source of possible contamination: [] Septic tank [] Lateral lines [] Pit privy [] Livestock pens [] Insecticide storage [X] Other (specify below) [] Sewer lines [] Cesspool [] Sewage lagoon [] Fuel storage [] Abandoned water well [] Watertight sewer lines [] Seepage pit [] Feedyard [] Fertilizer storage [] Oil well/gas well None Known Direction from well Distance from well

Table with 6 columns: FROM, TO, LITHOLOGIC LOG, FROM, TO, LITHO. LOG (cont.) or PLUGGING INTERVALS. Rows include Topsoil (0-4 ft), Clay, brown, hard, sandy (4-25 ft), Sand & gravel, coarse to fine, loose, clean (25-43 ft), and Shale, black, hard (43-45 ft).

7 CONTRACTOR'S OR LANDOWNER'S CERTIFICATION: This water well was [X] constructed, [] reconstructed, or [] plugged under my jurisdiction and was completed on (mo/day/year) 04/11/17 and this record is true to the best of my knowledge and belief. Kansas Water Well Contractor's License No. 185 This Water Well Record was completed on (mo/day/year) 04/12/17 under the business name of Clarke Well & Equipment, Inc. by (signature)

INSTRUCTIONS: Use typewriter or ball point pen. PLEASE PRESS FIRMLY and PRINT clearly. Please fill in blanks and check the correct answers. Send three copies (white, blue, pink) to Kansas Department of Health and Environment, Bureau of Water, Geology Section, 1000 SW Jackson St., Suite 420, Topeka, Kansas 66612-1367. Telephone 785-296-5522. Send one copy to WATER WELL OWNER and retain one for your records. Include fee of \$5.00 for each constructed well. Visit us at http://www.kdheks.gov/waterwell/index.html.