


1 LOCATION OF WATER WELL: Fraction NE 1/4 NW 1/4 NE 1/4 Section Number 29 Township Number T 15 S Range Number R 18 E/W

Distance and direction from nearest town or city street address of well if located within city?
 1/4 m W of 240th & Smoky Hill River Rd intsec, Schoenchen

2 WATER WELL OWNER: Kansas Corporation Commission
 RR#, St. Address, Box # : 2301 E. 13th Board of Agriculture, Division of Water Resources
 City, State, ZIP Code : Hays, Kansas 67601 Application Number:

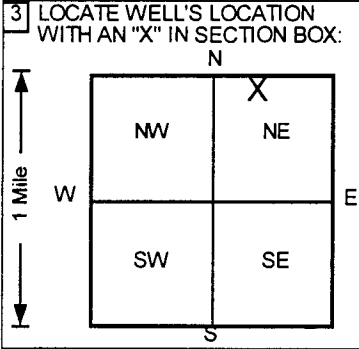

4 DEPTH OF COMPLETED WELL 25 ft. ELEVATION: 1932.9 ft.
 Depth(s) Groundwater Encountered 1. ft. 2. ft. 3. ft.
 WELL'S STATIC WATER LEVEL . . . 12.8 . . . ft. below land surface measured on mo/day/yr . . . 6/10/99
 Pump test data: Well water was . . . NA . . . ft. after hours pumping gpm
 Est. Yield . . NA . . . gpm: Well water was ft. after hours pumping gpm
 Bore Hole Diameter . . . 8 . . . in. to . . . 25 . . . ft., and in. to ft.
 WELL WATER TO BE USED AS: 5 Public water supply 8 Air conditioning 11 Injection well
 1 Domestic 3 Feedlot 6 Oil field water supply 9 Dewatering 12 Other (Specify below)
 2 Irrigation 4 Industrial 7 Lawn and garden only 10 Monitoring well
 Was a chemical/bacteriological sample submitted to Department? Yes.....No...; If yes, mo/day/yr sample was submitted
 Water Well Disinfected? Yes No

5 TYPE OF BLANK CASING USED: 5 Wrought iron 8 Concrete tile CASING JOINTS: Glued Clamped
 1 Steel 3 RMP (SR) 6 Asbestos-Cement 9 Other (specify below) Welded
 2 PVC 4 ABS 7 Fiberglass Threaded.
 Blank casing diameter 2 in. to . . . 12.5 . . . ft., Dia in. to ft., Dia in. to ft.
 Casing height above land surface . . . 23.04 . . . in., weight Sch 40 lbs./ft. Wall thickness or gauge No.
 TYPE OF SCREEN OR PERFORATION MATERIAL 7 PVC 10 Asbestos-cement
 1 Steel 3 Stainless steel 5 Fiberglass 8 RMP (SR) 11 Other (specify)
 2 Brass 4 Galvanized steel 6 Concrete tile 9 ABS 12 None used (open hole)
 SCREEN OR PERFORATION OPENINGS ARE: 5 Gauzed wrapped 8 Saw cut 11 None (open hole)
 1 Continuous slot 3 Mill slot 6 Wire wrapped 9 Drilled holes
 2 Louvered shutter 4 Key punched 7 Torch cut 10 Other (specify)
 SCREEN-PERFORATED INTERVALS: From 12.5 . . . ft. to . . . 22.5 . . . ft., From ft. to ft.
 From ft. to ft., From ft. to ft.
 GRAVEL PACK INTERVALS: From 10.5 . . . ft. to . . . 22.5 . . . ft., From ft. to ft.
 From ft. to ft., From ft. to ft.

6 GROUT MATERIAL: 1 Neat cement 2 Cement grout 3 Bentonite 4 Other
 Grout Intervals: From 0 ft. to . . . 2 ft., From 2 ft. to . . . 10.5 . . . ft., From ft. to ft.
 What is the nearest source of possible contamination:
 1 Septic tank 4 Lateral lines 7 Pit privy 10 Livestock pens 14 Abandoned water well
 2 Sewer lines 5 Cess pool 8 Sewage lagoon 11 Fuel storage 15 Oil well/Gas well
 3 Watertight sewer lines 6 Seepage pit 9 Feedyard 12 Fertilizer storage 16 Other (specify below)
 13 Insecticide storage Unknown
 Direction from well? How many feet?

| FROM | TO | LITHOLOGIC LOG | FROM | TO | PLUGGING INTERVALS |
|------|----|------------------------|------|----|-------------------------------|
| 0 | 1 | Topsoil, | | | |
| 1 | 4 | Clay Silt, | | | |
| 4 | 8 | Gravel, | | | |
| 8 | 11 | Clay, | | | |
| 11 | 14 | Sand Gravel, | | | |
| 14 | 17 | Sand Gravel, | | | |
| 17 | 20 | Sand Gravel, | | | |
| 20 | 21 | Sand Gravel, Dark Gray | | | |
| 21 | 23 | Shale, Light Gray | | | |
| 23 | 25 | Shale, Dark Gray | | | |
| | | | | | |
| | | | | | MW2 , Tag # , Abovegrade |
| | | | | | Project Name: KCC-Ruder Creek |
| | | | | | GeoCore # 796 , # |

7 CONTRACTOR'S OR LANDOWNER'S CERTIFICATION: This water well was (1) constructed, (2) reconstructed, or (3) plugged under my jurisdiction and was completed on (mo/day/year) 6/8/99 and this record is true to the best of my knowledge and belief.
 Kansas Water Well Contractor's License No. 527 This Water Well Record was completed on (mo/day/yr) 7/10/99
 under the business name of GeoCore Services, Inc. by (signature) *And Hill*

OFFICE USE ONLY
T
R
EW
SEC
1/4
1/4