


WATER WELL RECORD Form WWC-5 KSA 82a-1212 ID No. \_\_\_\_\_

<b>1 LOCATION OF WATER WELL:</b> County: <u>ELLIS</u>	Fraction <u>SW 1/4 SW 1/4 NE 1/4</u>	Section Number <u>25</u>	Township Number <u>T 18 15 S</u>	Range Number <u>R 18 EW</u>
--	---	-----------------------------	-------------------------------------	--------------------------------

Distance and direction from nearest town or city street address of well if located within city?  
6 miles South of MUNJOR KS

<b>2 WATER WELL OWNER :</b> <u>DONALD WERTH</u> RR#, St. Address, Box # : <u>1007 W 39th</u> City, State, ZIP Code : <u>HAYS KS 67601</u>	Board of Agriculture, Division of Water Resources Application Number:
---	--

<b>3 LOCATE WELL'S LOCATION WITH AN "X" IN SECTION BOX:</b>	<b>4 DEPTH OF COMPLETED WELL:</b> <u>32</u> ft. ELEVATION: _____ Depth(s) Groundwater Encountered 1. <u>30</u> ft. 2. _____ ft. 3. _____ ft. WELL'S STATIC WATER LEVEL <u>30</u> ft. below land surface measured on mo/day/yr <u>7-17-01</u> Pump test data: Well water was _____ ft. after _____ hours pumping _____ gpm Est. Yield <u>30</u> gpm; Well water was _____ ft. after _____ hours pumping _____ gpm Bore Hole Diameter <u>10</u> in. to <u>32</u> ft., and _____ in. to _____ ft. WELL WATER TO BE USED AS: <input checked="" type="checkbox"/> Domestic <input type="checkbox"/> Feedlot <input type="checkbox"/> Oil field water supply <input type="checkbox"/> Dewatering <input type="checkbox"/> Other (Specify below) <input type="checkbox"/> Irrigation <input type="checkbox"/> Industrial <input type="checkbox"/> Domestic (lawn & garden) <input type="checkbox"/> Monitoring well _____ Was a chemical/bacteriological sample submitted to Department? Yes. _____ No. <input checked="" type="checkbox"/> ; If yes, mo/day/yr sample was submitted _____ Water Well Disinfected? Yes _____ No <input checked="" type="checkbox"/>
---	--

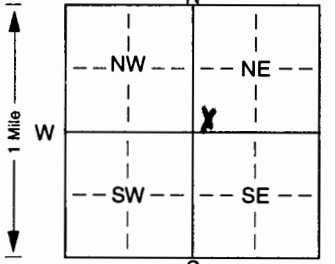

<b>5 TYPE OF BLANK CASING USED:</b> 1 Steel    3 RMP (SR)    5 Wrought iron    8 Concrete tile <input checked="" type="checkbox"/> PVC    4 ABS    6 Asbestos-Cement    9 Other (specify below) 7 Fiberglass Blank casing diameter <u>5</u> in. to <u>20</u> ft., Dia _____ in. to _____ ft., Dia _____ in. to _____ ft. Casing height above land surface <u>18</u> in., weight <u>160</u> lbs./ft. Wall thickness or gauge No. _____ <b>TYPE OF SCREEN OR PERFORATION MATERIAL:</b> 1 Steel    3 Stainless steel    5 Fiberglass <input checked="" type="checkbox"/> PVC    10 Asbestos-cement 2 Brass    4 Galvanized steel    6 Concrete tile    8 RMP (SR)    11 Other (specify) _____ 9 ABS    12 None used (open hole) <b>SCREEN OR PERFORATION OPENINGS ARE:</b> 1 Continuous slot <input checked="" type="checkbox"/> Mill slot    5 Gauzed wrapped    8 Saw cut    11 None (open hole) 2 Louvered shutter    4 Key punched    6 Wire wrapped    9 Drilled holes 7 Torch cut    10 Other (specify) _____ ft. <b>SCREEN-PERFORATED INTERVALS:</b> From <u>20</u> ft. to <u>32</u> ft., From _____ ft. to _____ ft. <b>GRAVEL PACK INTERVALS:</b> From <u>25</u> ft. to <u>32</u> ft., From _____ ft. to _____ ft. From _____ ft. to _____ ft., From _____ ft. to _____ ft.
---

<b>6 GROUT MATERIAL:</b> 1 Neat cement    2 Cement grout <input checked="" type="checkbox"/> Bentonite    4 Other _____ Grout Intervals: From <u>0</u> ft. to <u>25</u> ft., From _____ ft. to _____ ft., From _____ ft. to _____ ft. What is the nearest source of possible contamination: 1 Septic tank    4 Lateral lines    7 Pit privy    10 Livestock pens    14 Abandoned water well 2 Sewer lines    5 Cess pool    8 Sewage lagoon    11 Fuel storage    15 Oil well/Gas well 3 Watertight sewer lines    6 Seepage pit    9 Feedyard    12 Fertilizer storage    16 Other (specify below) Direction from well? _____ How many feet? _____
---

FROM	TO	LITHOLOGIC LOG	FROM	TO	PLUGGING INTERVALS
0	5	SURFACE CLAY			
5	20	FINE SAND			
20	25	MED SAND			
25	30	LARGE SAND			
30	32	BLUE SHALE			

<b>7 CONTRACTOR'S OR LANDOWNER'S CERTIFICATION:</b> This water well was <input checked="" type="checkbox"/> constructed, (2) reconstructed, or (3) plugged under my jurisdiction and was completed on (mo/day/year) <u>7-17-01</u> and this record is true to the best of my knowledge and belief. Kansas Water Well Contractor's Licence No. <u>444</u> under the business name of <u>ANDY ANDERSON DRILLING</u>	This Water Well Record was completed on (mo/day/yr) <u>7-18-01</u> by (signature) <i>Andy Anderson</i>
--	---

INSTRUCTIONS: Use typewriter or ball point pen. PLEASE PRESS FIRMLY and PRINT clearly. Please fill in blanks, underline or circle the correct answers. Send top three copies to Kansas Department of Health and Environment, Bureau of Water, Topeka, Kansas 66620-0001. Telephone 785-296-5524. Send one to WATER WELL OWNER and retain one for your records. Fee of \$5.00 for each constructed well.