


1	LOCATION OF WATER WELL:	Fraction	Section Number	Township Number	Range Number
County:	<u>Ellis</u>	<u>1/4 SE 1/4 NW 1/4 NE</u>	<u>21</u>	<u>15 5</u>	<u>18</u> <u>EN</u>

Distance and direction from nearest town or city street address of well if located within city?
9 miles south of HAYS on 183 1/4 west

2 WATER WELL OWNER: Fidelis Engel
 RR #, St. Address, Box #: 755 260th
 City, State, ZIP Code: HAYS KS 67601
 Board of Agriculture, Division of Water Resources
 Application Number: _____

3	MARK WELL'S LOCATION WITH AN "X" IN SECTION BOX:	4	DEPTH OF WELL <u>240</u> ft. WELL'S STATIC WATER LEVEL <u>150</u> ft. WELL WAS USED AS: <input checked="" type="checkbox"/> 1 Domestic <input type="checkbox"/> 2 Irrigation <input type="checkbox"/> 3 Feedlot <input type="checkbox"/> 4 Industrial <input type="checkbox"/> 5 Public Water Supply <input type="checkbox"/> 6 Oil Field Water Supply <input type="checkbox"/> 7 Domestic (Lawn & Garden) <input type="checkbox"/> 8 Air Conditioning <input type="checkbox"/> 9 Dewatering <input type="checkbox"/> 10 Monitoring Well <input type="checkbox"/> 11 Injection Well <input type="checkbox"/> 12 Other
---	--	---	---

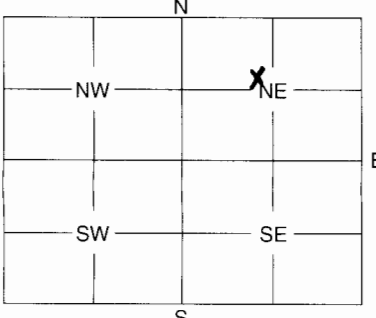

Was a chemical / bacteriological sample submitted to Department? Yes No
 If yes, mo/day/yr sample was submitted

Water Well Disinfected: Yes No

5 TYPE OF BLANK CASING USED:
 1 Steel 3 RMP (SR) 5 Wrought 7 Fiberglass 9 Other (Specify below)
 2 PVC 4 ABS 6 Asbestos-Cement 8 Concrete Tile

Blank casing diameter 2 in. Was casing pulled? Yes No If yes, how much

Casing height above or below land surface 9.4 in.

6 GROUT PLUG MATERIAL: 1 Neat cement 2 Cement grout 3 Bentonite 4 Other

Grout Plug Intervals: From 158 ft. to 100 ft., From 70 ft. to 8 ft., From to ft.

What is the nearest source of possible contamination:
 1 Septic tank 6 Seepage pit 11 Fuel storage 16 Other (specify below)
 2 Sewer lines 7 Pit privy 12 Fertilizer storage

3 Watertight sewer lines 8 Sewage lagoon 13 Insecticide storage

4 Lateral lines 9 Feedyard 14 Abandoned water well

5 Cess pool 10 Livestock pens 15 Oil well/Gas well

Direction from well? How many feet?

FROM	TO	PLUGGING MATERIALS
<u>240</u>	<u>158</u>	<u>GRAVEL</u>
<u>158</u>	<u>100</u>	<u>Bentonite</u>
<u>100</u>	<u>70</u>	<u>CLAY</u>
<u>70</u>	<u>8</u>	<u>Bentonite</u>
<u>8</u>	<u>0</u>	<u>CLAY</u>

Received A waiver
 From Richard Harper
 on 11-26-07

7 CONTRACTOR'S OF LANDOWNER'S CERTIFICATION: This water well was plugged under my jurisdiction and was completed on (mo/day/year) 11-26-07 and this record is true to the best of my knowledge and belief. Kansas Water Well Contractor's License No. 624 This Water Well Record was completed on (mo/day/year) 12-9-07 under the business name of Town & Country Water Well Service by (signature) Al Tre

INSTRUCTIONS: Use typewriter or ball point pen. Please press firmly and print clearly. Please fill in blanks, underline or circle the correct answers. Send top three copies to Kansas Department of Health and Environment, Bureau of Water, Geology Section, 1000 SW Jackson St., Ste. 420, Topeka, Kansas 66612-1367. Telephone: 785/296-5522. Send one to Water Well Owner and retain one for your records.