


Well #12

1	LOCATION OF WATER WELL:	Fraction	Section Number	Township Number	Range Number
County:	ELLIS	SE 1/4 NE 1/4 SE 1/4	28	T 15 S	18 E 10

Distance and direction from nearest town or city street address of well if located within city?
 .4 miles North of Schomden Rd + 1/6 mile West of 250th 38° 42' 56.22" N (Approx)
99° 19' 15.69" W (Approx)

2	WATER WELL OWNER: City of Hays 1000 Vine RR #, St. Address, Box #: Hays, KS 67601 City, State, ZIP Code	Board of Agriculture, Division of Water Resources Application Number:
---	--	--

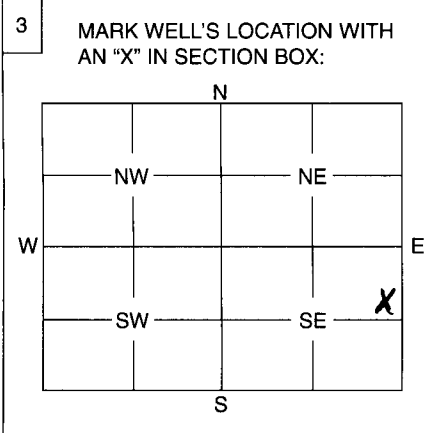

4 DEPTH OF WELL 54 ft.
 WELL'S STATIC WATER LEVEL 19 ft.
 WELL WAS USED AS:

1 Domestic	<input checked="" type="checkbox"/> Public Water Supply	9 Dewatering
2 Irrigation	6 Oil Field Water Supply	10 Monitoring Well
3 Feedlot	7 Domestic (Lawn & Garden)	11 Injection Well
4 Industrial	8 Air Conditioning	12 Other

Was a chemical / bacteriological sample submitted to Department? Yes No
 If yes, mo/day/yr sample was submitted

Water Well Disinfected: Yes No

5 TYPE OF BLANK CASING USED:

<input checked="" type="checkbox"/> Steel	3 RMP (SR)	5 Wrought	7 Fiberglass	9 Other (Specify below)
2 PVC	4 ABS	6 Asbestos-Cement	8 Concrete Tile	

Blank casing diameter 16 in. Was casing pulled? Yes No If yes, how much 3'
 Casing height above or below land surface -36 in.

6 GROUT PLUG MATERIAL: 1 Neat cement Cement grout 3 Bentonite 4 Other

Grout Plug Intervals: From 25 ft. to 3' ft., From ft. to ft., From to ft.

What is the nearest source of possible contamination:

1 Septic tank	6 Seepage pit	11 Fuel storage	<input checked="" type="checkbox"/> Other (specify below)
2 Sewer lines	7 Pit privy	12 Fertilizer storage	None known
3 Watertight sewer lines	8 Sewage lagoon	13 Insecticide storage	
4 Lateral lines	9 Feedyard	14 Abandoned water well	
5 Cess pool	10 Livestock pens	15 Oil well/Gas well	

Direction from well? How many feet?

FROM	TO	PLUGGING MATERIALS
54'	25'	Chlorinated Sand
25'	3'	Cement Grout
3'	0'	Native Soil

* Pedestal Removed

7 CONTRACTOR'S OF LANDOWNER'S CERTIFICATION: This water well was plugged under my jurisdiction and was completed on (mo/day/year) 4/12/10 and this record is true to the best of my knowledge and belief. Kansas Water Well Contractor's License No. 1102 This Water Well Record was completed on (mo/day/year) under the business name of Layne Christensen Company
 by (signature)

INSTRUCTIONS: Use typewriter or ball point pen. Please press firmly and print clearly. Please fill in blanks, underline or circle the correct answers. Send top three copies to Kansas Department of Health and Environment, Bureau of Water, Geology Section, 1000 SW Jackson St., Ste. 420, Topeka, Kansas 66612-1367. Telephone: 785/296-5522. Send one to Water Well Owner and retain one for your records.