


TH 19

1	LOCATION OF WATER WELL:	Fraction	Section Number	Township Number	Range Number
	County: <u>Ellis</u>	<u>NW 1/4 NE 1/4 NE 1/4</u>	<u>32</u>	<u>T 15 S</u>	<u>R 18</u> <small>EW</small>

Distance and direction from nearest town or city street address of well if located within city? 38° 42' (Approx)
1/4 mile west of 240th + 1/8 mile South of Schoenchen Rd 99° 20' (Approx)

2	WATER WELL OWNER: <u>City of Hays</u>	Board of Agriculture, Division of Water Resources
	RR #, St. Address, Box #: <u>1000 Winn</u>	Application Number:
	City, State, ZIP Code: <u>Hays KS 67601</u>	

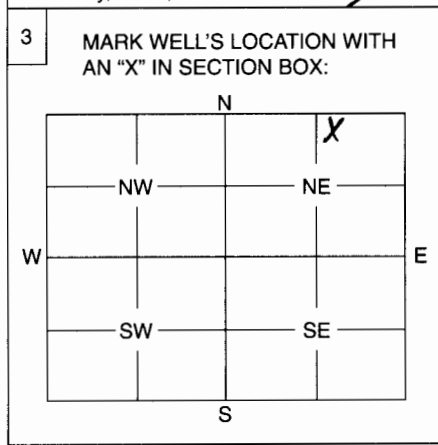

4	DEPTH OF WELL <u>70</u> ft.												
	WELL'S STATIC WATER LEVEL <u>18</u> ft.												
	WELL WAS USED AS:												
	<table border="0"> <tr> <td>1 Domestic</td> <td>5 Public Water Supply</td> <td>9 Dewatering</td> </tr> <tr> <td>2 Irrigation</td> <td>6 Oil Field Water Supply</td> <td>10 Monitoring Well</td> </tr> <tr> <td>3 Feedlot</td> <td>7 Domestic (Lawn & Garden)</td> <td>11 Injection Well</td> </tr> <tr> <td>4 Industrial</td> <td>8 Air Conditioning</td> <td>12 Other <u>Test Hole</u></td> </tr>
	Was a chemical / bacteriological sample submitted to Department? Yes <u>No</u>												
	If yes, mo/day/yr sample was submitted												
	Water Well Disinfected: <u>Yes</u> No												

5	TYPE OF BLANK CASING USED:										
	<table border="0"> <tr> <td>1 Steel</td> <td>3 RMP (SR)</td> <td>5 Wrought</td> <td>7 Fiberglass</td> <td>9 Other (Specify below)</td> </tr> <tr> <td>2 PVC</td> <td>4 ABS</td> <td>6 Asbestos-Cement</td> <td>8 Concrete Tile</td> <td><u>None 2" Bore hole</u></td> </tr>
	Blank casing diameter in. Was casing pulled? Yes No If yes, how much										
	Casing height above or below land surface in.										

6	GROUT PLUG MATERIAL: 1 Neat cement 2 Cement grout <u>3 Bentonite</u> 4 Other																				
	Grout Plug Intervals: From <u>70</u> ft. to <u>0</u> ft., From ft. to ft., From to																				
	What is the nearest source of possible contamination:																				
	<table border="0"> <tr> <td>1 Septic tank</td> <td>6 Seepage pit</td> <td>11 Fuel storage</td> <td>16 Other (specify below)</td> </tr> <tr> <td>2 Sewer lines</td> <td>7 Pit privy</td> <td>12 Fertilizer storage</td> <td><u>None known</u></td> </tr> <tr> <td>3 Watertight sewer lines</td> <td>8 Sewage lagoon</td> <td>13 Insecticide storage</td> <td></td> </tr> <tr> <td>4 Lateral lines</td> <td>9 Feedyard</td> <td>14 Abandoned water well</td> <td></td> </tr> <tr> <td>5 Cess pool</td> <td>10 Livestock pens</td> <td>15 Oil well/Gas well</td> <td></td> </tr>
	Direction from well? How many feet?																				

FROM	TO	PLUGGING MATERIALS
<u>70</u>	<u>0</u>	<u>Bentonite Hole Plug</u>

7	CONTRACTOR'S OF LANDOWNER'S CERTIFICATION: This water well was plugged under my jurisdiction and was completed on (mo/day/year) <u>3/9/10</u> and this record is true to the best of my knowledge and belief. Kansas Water Well Contractor's License No. <u>107</u> This Water Well Record was completed on (mo/day/year) <u>5/9/10</u> under the business name of <u>Layne Christensen Company</u> by (signature) <u>[Signature]</u>
---	---

INSTRUCTIONS: Use typewriter or ball point pen. Please press firmly and print clearly. Please fill in blanks, underline or circle the correct answers. Send top three copies to Kansas Department of Health and Environment, Bureau of Water, Geology Section, 1000 SW Jackson St., Ste. 420, Topeka, Kansas 66612-1367. Telephone: 785/296-5522. Send one to Water Well Owner and retain one for your records.