

WATER WELL RECORD Form WWC-5 KSA 82a-1212


1 LOCATION OF WATER WELL: **ELLIS** Fraction **SW 1/4 SW 1/4 NE 1/4** Section Number **28** Township Number **T 15 S** Range Number **R 18 E/W**

County: Distance and direction from nearest town or city street address of well if located within city?

1/2 mile North of Schoenchen

2 WATER WELL OWNER: **DWIGHT ALLENBAUGH**
 RR#, St. Address, Box #: **2904 COUNTRY LANE**
 City, State, ZIP Code: **HAYS KS 67601**
 Board of Agriculture, Division of Water Resources
 Application Number:

3 LOCATE WELL'S LOCATION WITH AN "X" IN SECTION BOX:

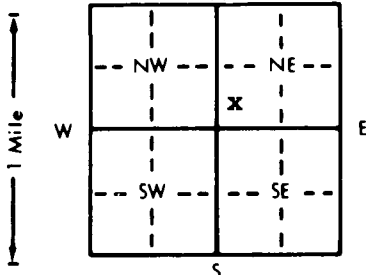

4 DEPTH OF COMPLETED WELL: **40** ft. ELEVATION:
 Depth(s) Groundwater Encountered 1. **21** ft. 2. ft. 3. ft.
 WELL'S STATIC WATER LEVEL: **21** ft. below land surface measured on **5-20-98**
 Pump test data: Well water was ft. after hours pumping gpm
 Est. Yield **40** gpm Well water was ft. after hours pumping gpm
 Bore Hole Diameter: **10** in. to **40** ft. and in. to ft.
 WELL WATER TO BE USED AS:
 Domestic 3 Feedlot 6 Oil field water supply 8 Air conditioning 9 Dewatering 10 Monitoring well 11 Injection well 12 Other (Specify below)
 2 Irrigation 4 Industrial 7 Lawn and garden only 10 Monitoring well
 Was a chemical/bacteriological sample submitted to Department? Yes No If yes, mo/day/yr sample was submitted
 Water Well Disinfected? Yes No

5 TYPE OF BLANK CASING USED:
 Steel 3 RMP (SR) 5 Wrought iron 8 Concrete tile CASING JOINTS: Glued Clamped
 PVC 4 ABS 7 Fiberglass Welded
 Blank casing diameter **5** in. to **22** ft. Dia. in. to ft. Dia. in. to ft.
 Casing height above land surface: **18** in., weight **160** lbs./ft. Wall thickness or gauge No.
 TYPE OF SCREEN OR PERFORATION MATERIAL: PVC 10 Asbestos-cement
 1 Steel 3 Stainless steel 5 Fiberglass 8 RMP (SR) 11 Other (specify)
 2 Brass 4 Galvanized steel 6 Concrete tile 9 ABS 12 None used (open hole)
 SCREEN OR PERFORATION OPENINGS ARE:
 1 Continuous slot Mill slot 5 Gauzed wrapped 8 Saw cut 11 None (open hole)
 2 Louvered shutter 4 Key punched 6 Wire wrapped 9 Drilled holes
 7 Torch cut 10 Other (specify)
 SCREEN-PERFORATED INTERVALS: From **22** ft. to **40** ft. From ft. to ft.
 From ft. to ft. From ft. to ft.
 GRAVEL PACK INTERVALS: From **22** ft. to **40** ft. From ft. to ft.
 From ft. to ft. From ft. to ft.

6 GROUT MATERIAL: 1 Neat cement 2 Cement grout Bentonite 4 Other
 Grout Intervals: From **0** ft. to **22** ft. From ft. to ft. From ft. to ft. From ft. to ft.
 What is the nearest source of possible contamination:
 1 Septic tank 4 Lateral lines 7 Pit privy 10 Livestock pens 14 Abandoned water well
 2 Sewer lines 5 Cess pool 8 Sewage lagoon 11 Fuel storage 15 Oil well/Gas well
 3 Watertight sewer lines 6 Seepage pit 9 Feedyard 12 Fertilizer storage 16 Other (specify below)
 13 Insecticide storage
 Direction from well? How many feet?

FROM	TO	LITHOLOGIC LOG	FROM	TO	PLUGGING INTERVALS
0	3	SURFACE CLAY			
3	18	HARD GRAY CLAY			
18	24	FINE SAND			
24	28	MED SAND			
28	38	LARGE SAND			
38	39	BLUE MUD			
39	40	BLUE SHALE			

7 CONTRACTOR'S OR LANDOWNER'S CERTIFICATION: This water well was constructed, (2) reconstructed, or (3) plugged under my jurisdiction and was completed on (mo/day/year) **5-20-98** and this record is true to the best of my knowledge and belief. Kansas Water Well Contractor's License No. **444** This Water Well Record was completed on (mo/day/yr) **5-20-98** under the business name of **ANDY ANDERSON DRILLING** by (signature) *Andy Anderson*

INSTRUCTIONS: Use typewriter or ball point pen. PLEASE PRESS FIRMLY and PRINT clearly. Please fill in blanks, underline or circle the correct answers. Send top three copies to Kansas Department of Health and Environment, Bureau of Water, Topeka, Kansas 66620-0001. Telephone: 913-296-5545. Send one to WATER WELL OWNER and retain one for your records.

OFFICE USE ONLY
T
R
EW
SEC.
1/4
1/4
1/4